



**Addendum No. 5**  
Page 1 of 1

**DATE:** May 12, 2016

Joliet Junior College  
1215 Houbolt Road  
Joliet, IL 60431

**TO:** Prospective Bidders  
**SUBJECT:** Addendum No. 5  
**PROJECT NAME:** City Center Campus Audio Visual Equipment  
**JJC PROJECT NO.:** B16016

This Addendum forms a part of the Bidding and Contract Documents and modifies the original bidding document as posted on the JJC website. Acknowledge receipt of this addendum in the space provided on the Bid Form. FAILURE TO DO SO MAY SUBJECT BIDDER TO DISQUALIFICATION.

---


**Questions Received:**

1. Per Addendum #3 question #35 Heights of cameras: The response is that the “cameras will be mounted no higher than 9’ a.f.f.”. Per Drawing TA-500 conduit layout, it appears that all drop ceilings are 10’ and above. Per Drawing TA-900 detail 1, it shows the ceiling at 18’. (18’ high ceilings are a major concern in determining costs.) Can you please provide the ceiling and drop ceiling heights and/or the architectural drawings showing ceiling heights. These drawing were not provided with the bid package and are now required.  
***Architectural reflected ceiling plans are attached for reference. Per addendum #3, cameras will be mounted no higher than 9’-0” a.f.f., except for the ceiling-mounted cameras at Demonstration Classroom 2003 which are 11’-0” a.f.f..***  
***The section shown on sheet TA-900 is of Demonstration Classroom 2003 and is intended to indicate monitor locations on the sloped ceiling element. The 18’ dimension is to top of floor above, not ceiling. The cameras in this space are mounted to the ceiling area over the instructor’s island at 11’-0” a.f.f., and to the rear wall above the view window from the Control Room. Please note that the junction boxes for cameras in acoustical panel ceilings will be mounted to T-bars and attached to the ceiling grid system.***
2. In Addendum #3 response to questions #11 and #24 need clarification. If the Vaddio One Link boxes are to be quoted for the Vaddio cameras, the Extron Master quote would appear to need updating to reflect the removal of some HDBT transmitters and changing out of Input cards on for the XTPII switcher frame. System drawing TA-704, TA-704A, TA-705 and TA-705A show Extron HdBase-T transmitters as the transportation method for Camera video to and into the XTPII switcher. If the Vaddio ONE LINK is used the quantity of HdBase-T transmitters will need to be reduced and the input cards for the switcher would need to be replaced with HDMI input boards it would appear. Please advise as to what course of action should be taken.  
***The bid should be based on the quantities shown on the documents. Any reductions on transmitter quantities that may be needed to conform with the Vaddio One Link boxes will be resolved post-bid.***

**Clarifications:**

- 1. To maintain the schedule of the interior build-out, the electric projection screen (EPS-01) will be furnished by the Owner, not by the bidder. The model ordered is DaLite 20848LS, with internal junction box, Da-Mat surface, and key locking cover plate for LVC switch. Installation responsibilities remain as described on the AV Equipment Provisioning Matrix.***

**End of addendum #5**

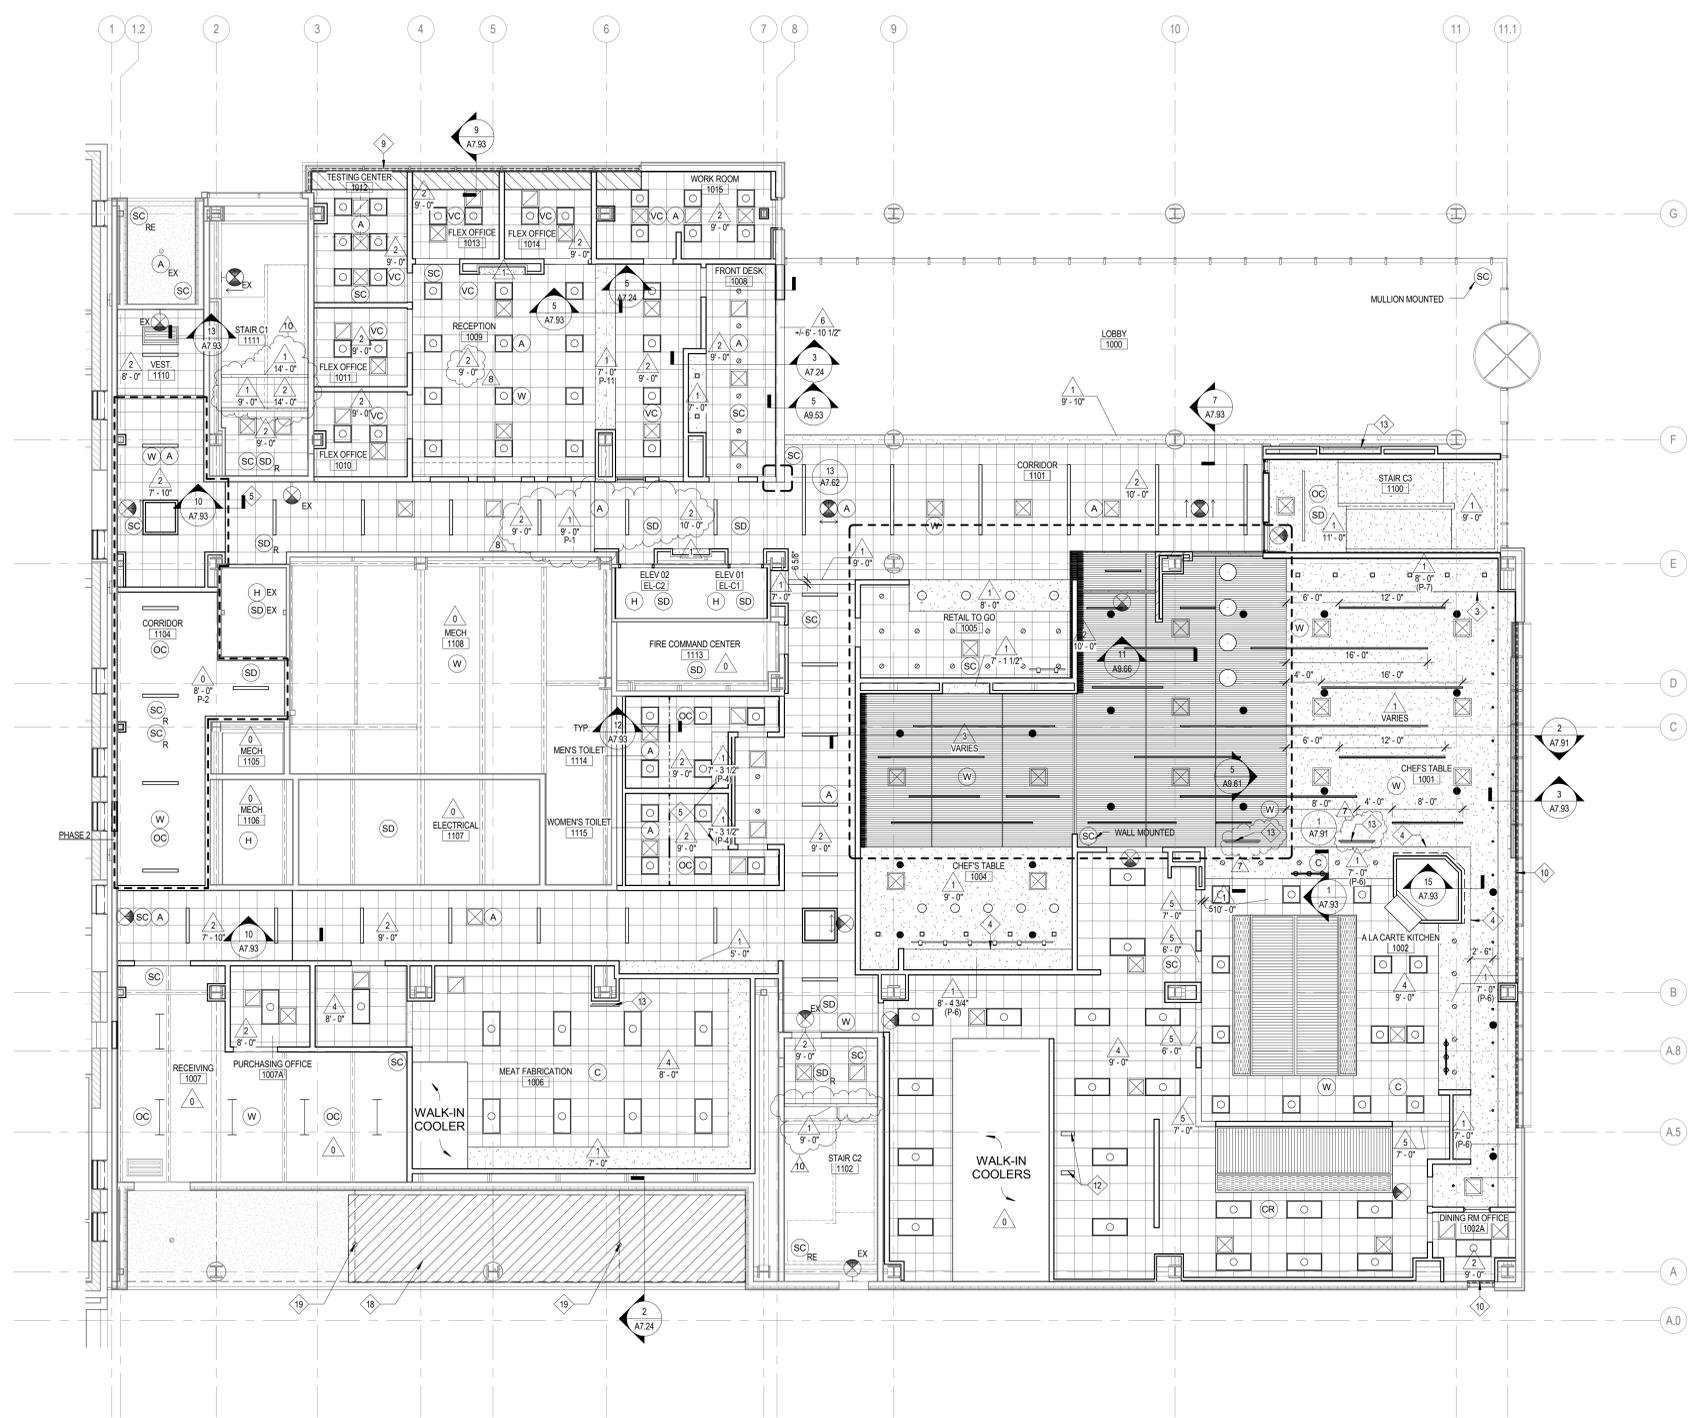

**CEILING TYPES:**

TYPE	DESCRIPTION
0	EXPOSED STRUCTURE
1	5/8" PAINTED GYP BOARD ON METAL FRAMING
2	2X2 ACOUSTICAL PANEL SYSTEM
3	WOOD GRILL CEILING PANELS - 3/4" x 2 1/4" SLATS ON PAINTED FLAT BACKER W BLACK FELT BACKER
4	2X2 VINYL-FACED GYP BOARD PANEL CEILING SYSTEM
5	TILE ON CEMENTITIOUS BACKER ON METAL FRAMING
6	STAINLESS STEEL PANEL
7	WOOD GRILL CEILING PANELS - 5/8" x 2 1/4" SLATS ON PAINTED FLAT BACKER
8	ACOUSTIC PLASTER ON 5/8" PAINTED GYP BOARD ON METAL FRAMING

- RCP GENERAL NOTES:**
- ALL HEATING, VENTILATION, ELECTRICAL, PLUMBING, AND FIRE PROTECTION ITEMS ARE SHOWN ON ARCHITECTURAL REFLECTED CEILING PLANS FOR REFERENCE AND COORDINATION ONLY. REFER TO HEATING, VENTILATION, ELECTRICAL, PLUMBING, AND FIRE PROTECTION DRAWINGS FOR ACTUAL QUANTITIES. IN CASE OF CONFLICT THE ARCHITECTURAL REFLECTED CEILING PLAN SHALL GOVERN LOCATION OF THESE ITEMS.
  - IN AREAS THAT DO NOT HAVE ARCHITECTURAL REFLECTED CEILING PLANS YET REQUIRE NEW ITEMS TO BE INSTALLED IN OR ABOVE THE CEILING PLANE, CONTRACTOR SHALL REMOVE AND REINSTALL, REPLACE OR MODIFY EXISTING CEILING CONSTRUCTION TO ACCOMMODATE NEW WORK. ANY NEW CEILING AREAS SHALL MATCH EXISTING ADJACENT FINISHES.
  - CENTER ALL FIXTURES IN CEILING TILES AND FIELD VERIFY GRID LAYOUT FOR PROPER FIXTURE LOCATION. ALIGN ALL FIXTURES IN BOTH DIRECTIONS OF CEILING TILE (UNO).
  - CENTER ALL SPRINKLER HEADS IN CEILING TILES.
  - ALL GYP. BD. CEILINGS TO BE PAINTED P-3 UNLESS OTHERWISE NOTED ON PLANS.
  - EXTEND FACE OF ALL GYP. BD. SOFFITS AND HEADERS 4" MIN. BEYOND FINISHED CEILING ABOVE U.O.
  - WHERE CEILING TYPE IS SPECIFIED AND AN ASSOCIATED PAINT COLOR IS INDICATED ON THE RCP, ALL STRUCTURAL, MEP, AND TECHNOLOGY INFRASTRUCTURE TO BE PAINTED WITHIN THOSE EXTENTS.

- RCP REFERENCED NOTES:**
- DASHED LINE INDICATES EXTENT OF ALTERNATE BID #2 TO BUILD-OUT PRODUCTION LAB 5001. REFER TO PLAN 2 ON A2.51 FOR SCOPE OF WORK UNDER ALTERNATE BID.
  - PAINT FACE OF GYP. BD. SOFFIT P-6.
  - PAINT FACE OF GYP. BD. SOFFIT P-7.
  - PAINT FACE OF GYP. BD. SOFFIT P-6.
  - PAINT FACE OF SOFFIT P-4.
  - PAINT STRUCTURE ABOVE P-4 (NOT USED).
  - PROVIDE 6" METAL PERIMETER TRIM TRANSITION.
  - BOUNDARY OF INDIVIDUAL SUSPENDED CEILING TILE GRIDS.
  - SURFACE MOUNTED ROLLER SHADE.
  - RECESSED ROLLER SHADE.
  - DISH WASHER EXHAUST DUCT.
  - DIFFUSERS & DEVICES SHOWN FOR REFERENCE - SUSPEND ABOVE WOOD GRILLE CEILING.
  - DISH WASHER EXHAUST DUCT.
  - FUTURE T.V. DIGITAL DISPLAY, BY USING AGENCY - N.I.C.
  - SECURITY GRILLE LOCATED ABOVE SAT CEILING SYSTEM.
  - MOTORIZED PROJECTION SCREEN.
  - REMOVE SCRM AT DIFFUSER LOCATION. MOUNT DIFFUSERS FLUSH WITH BACK OF WOOD SLATS.
  - HATCH INDICATES AREA OF NEW EFS SOFFIT. DASHED LINE INDICATES CONTROL JOINT LOCATION. E. C. TO REINSTALL EXISTING LIGHT FIXTURES - SEE ELECTRICAL DRAWINGS.
  - REINSTALL EXISTING LIGHT FIXTURE - BY E. C.

**RCP SYMBOLS LEGEND:**

NOTE: REFER TO M.E.P.P. DRAWINGS FOR ADDITIONAL INFORMATION ON MECHANICAL, ELECTRICAL, AND FIRE PROTECTION SYSTEMS

- CEILING TYPE
- CEILING ELEVATION A.F.F.
- SUSPENDED ACOUSTICAL TILE CEILING
- GYP BOARD CEILING OR SOFFIT
- LINEAR WOOD SLAT CEILING SYSTEM
- WOOD PANEL CEILING
- GREASE EXHAUST HOOD
- PSP MAKE UP DIFFUSER
- RADIANT HEAT PANEL, BY H.C.
- ROLLER SHADE (TYP.)
- RECESSED 2"x4" FLUORESCENT LIGHT FIXTURE, BY E.C.
- RECESSED 2"x2" FLUORESCENT LIGHT FIXTURE, BY E.C.
- RECESSED FLUORESCENT LIGHT LINEAR FIXTURE, BY E.C.
- RECESSED 4"x4" FLUORESCENT LIGHT FIXTURE, BY E.C.
- SURFACE MOUNT 4"x4" FLUORESCENT LIGHT FIXTURE, BY E.C.
- SMALL PENDANT LIGHT FIXTURE, BY E.C.
- RECESSED DOWN LIGHT, BY E.C.
- HEAT LAMP, BY E.C.
- RECESSED DOWN LIGHT, BY E.C.
- PENDANT LIGHT MOUNT FIXTURE, BY E.C.
- PENDANT LIGHT MOUNT LINEAR FIXTURE, BY E.C.
- PENDANT LIGHT MOUNT FIXTURE SMALL, BY E.C.
- PENDANT LIGHT MOUNT FIXTURE LARGE, BY E.C.
- SPRINKLER HEAD, BY SPC
- WALL LIGHT MOUNT FIXTURE, BY E.C.
- PENDANT LIGHT HUNG FLUORESCENT STRIP FIXTURE, BY E.C.
- RECESSED LIGHT LINEAR FLUORESCENT FIXTURE, BY E.C.
- WALL LIGHT MOUNT FLUORESCENT FIXTURE, BY E.C.
- TRACK MOUNT LIGHT FIXTURE, BY E.C.
- CEILING MOUNTED PROJECTOR
- SCREEN - FURNISHED BY UA, INSTALLED BY G.C. - N.I.C.
- EXIT SIGN - SEE CODE COMPLIANCE PLAN, BY E.C.
- HEAT DETECTOR, BY E.C.
- SMOKE DETECTOR, BY E.C.
- EXISTING SMOKE DETECTOR, RELOCATED BY E.C.
- FIRE ALARM DEVICE, BY E.C.
- SPEAKER, N.I.C.
- CLOSED CIRCUIT CAMERA, VERIFY DIRECTION, BY E.C.
- CAMERA, N.I.C.
- OCCUPANT SENSOR, BY E.C.
- WIRELESS ACCESS POINT, BY E.C.
- VACANCY SENSOR, BY E.C.
- LIGHT SENSOR, BY E.C.
- CORD REEL, BY E.C.
- INDICATES EXISTING FIXTURE
- REMOVE AND RELOCATE EXISTING FIXTURE, BY E.C.
- RETURN AIR GRILLE, BY V.C.
- SUPPLY AIR GRILLE, BY V.C.
- LINEAR DIFFUSER - SUPPLY/RETURN, BY V.C.
- ACCESS PANEL
- CABINET UNIT HEATER OR FAN COIL UNIT, BY H.C.

1 LEVEL 1 - RCP  
1/8" = 1'-0"

NOTE: CONTRACTOR SHALL VERIFY ALL DIMENSIONS AND CONDITIONS AT JOB SITE AND BE FULLY RESPONSIBLE FOR SAME.

**REVISIONS**

NO.	DESCRIPTION	DATE
7	ISSUED FOR CONSTRUCTION	2015-07-31
8	RFP CD G-10, E-4	2016-04-15
8	ASI-002	2016-04-16
10	RFP CD G-19	2016-05-05

DRAWN	PREPARED	OFF.
CHECKED	APPROVED	

**DKA** DEMONICK ARCHITECTS  
125 N. HALSTED STREET, SUITE 301, CHICAGO, IL 60661 P: 312.496.0000

**KJWW** ENGINEERING  
1100 WARRENVILLE ROAD, #400W NAPERVILLE, IL 60563 T: 630.527.2320

**E.F. WHITNEY, INC.**  
568 ANN STREET BIRMINGHAM, MI 48009 T: 248.644.0990

**BOARD** Δελεγορωσεφ C B I L L T


State of Illinois  
Pat Quinn, Governor  
Illinois Capital Development Board

**Building a Better Illinois**

**ISSUED FOR CONSTRUCTION**  
**REFLECTED CEILING PLAN - LEVEL 1**

**CITY CENTER CAMPUS**  
**JOLIET JUNIOR COLLEGE**

PROJECT NO. CDB 810-048-023  
DATE DEC. 12, 2014  
SHEET NO. **A2.12** OF SHEETS

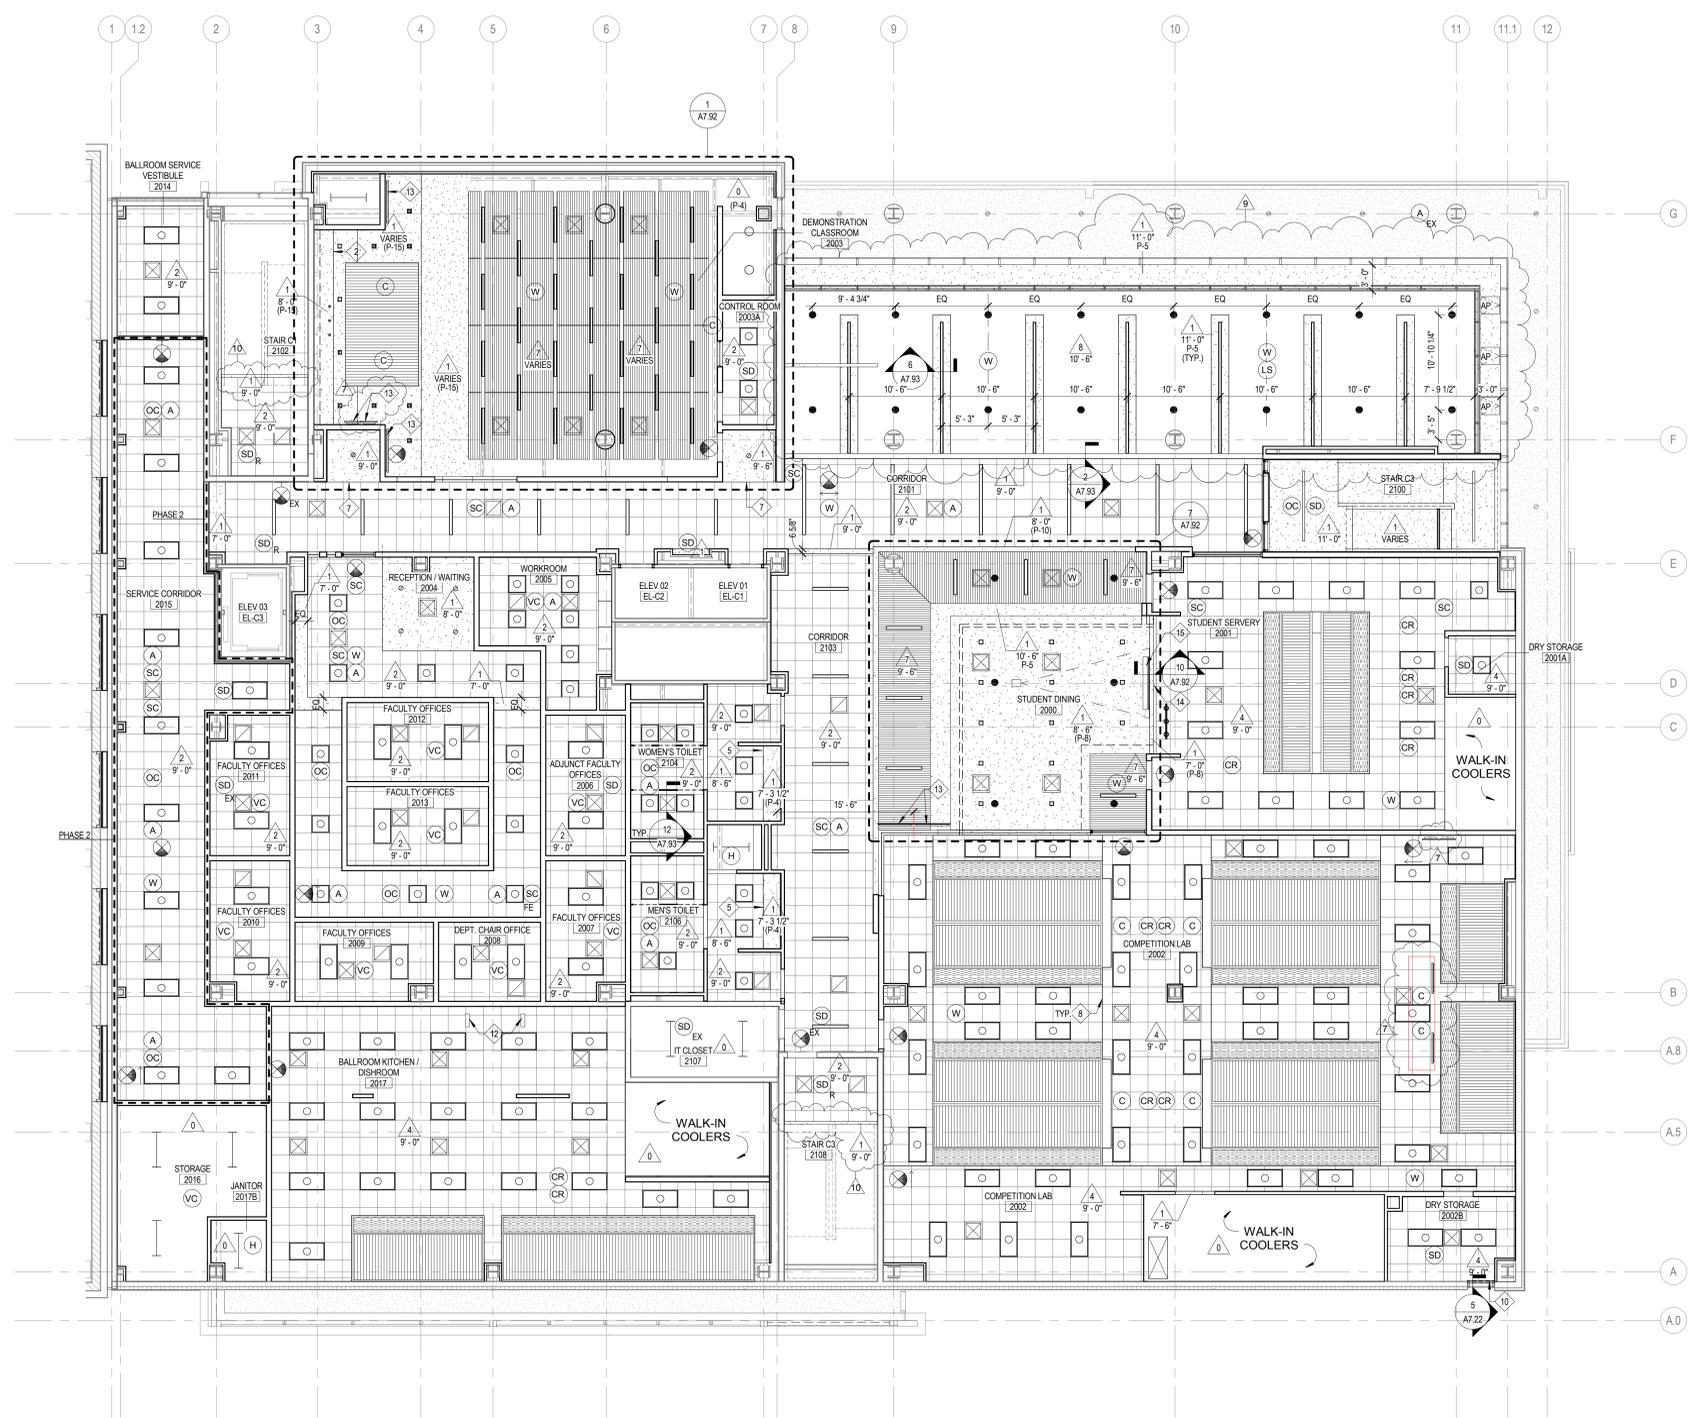

CEILING TYPES:	
TYPE	DESCRIPTION
0	EXPOSED STRUCTURE
1	5/8" PAINTED GYP BOARD ON METAL FRAMING
2	2X2 ACOUSTICAL PANEL SYSTEM
3	WOOD GRILL CEILING PANELS - 3/4" x 2 1/4" SLATS ON PAINTED FLAT BACKER W/ BLACK FELT BACKER
4	2X2 VINYL-FACED GYP BOARD PANEL CEILING SYSTEM
5	TILE ON CEMENTITIOUS BACKER ON METAL FRAMING
6	STAINLESS STEEL PANEL
7	WOOD GRILL CEILING PANELS - 5/8" x 2 1/4" SLATS ON PAINTED FLAT BACKER
8	ACOUSTIC PLASTER ON 5/8" PAINTED GYP BOARD ON METAL FRAMING


- RCP GENERAL NOTES:**
- ALL HEATING, VENTILATION, ELECTRICAL, PLUMBING, AND FIRE PROTECTION ITEMS ARE SHOWN ON ARCHITECTURAL REFLECTED CEILING PLANS FOR REFERENCE AND COORDINATION ONLY. REFER TO HEATING, VENTILATION, ELECTRICAL, PLUMBING, AND FIRE PROTECTION DRAWINGS FOR ACTUAL QUANTITIES. IN CASE OF CONFLICT THE ARCHITECTURAL REFLECTED CEILING PLAN SHALL GOVERN LOCATION OF THESE ITEMS.
  - IN AREAS THAT DO NOT HAVE ARCHITECTURAL REFLECTED CEILING PLANS YET REQUIRE NEW ITEMS TO BE INSTALLED IN OR ABOVE THE CEILING PLANE. CONTRACTOR SHALL REMOVE AND REINSTALL, REPLACE OR MODIFY EXISTING CEILING CONSTRUCTION TO ACCOMMODATE NEW WORK. ANY NEW CEILING AREAS SHALL MATCH EXISTING ADJACENT FINISHES.
  - CENTER ALL FIXTURES IN CEILING TILES AND FIELD VERIFY GRID LAYOUT FOR PROPER FIXTURE LOCATION. ALIGN ALL FIXTURES IN BOTH DIRECTIONS OF CEILING TILE. (LNG)
  - CENTER ALL SPRINKLER HEADS IN CEILING TILES.
  - ALL GYP. BD. CEILING TO BE PAINTED P-2 UNLESS OTHERWISE NOTED ON PLANS.
  - EXTEND FACE OF ALL GYP. BD. SOFFITS AND HEADERS 4" MIN. BEYOND FINISHED CEILING ABOVE U.O.
  - WHERE CEILING TYPE IS SPECIFIED AND AN ASSOCIATED PAINT COLOR IS INDICATED ON THE RCP, ALL STRUCTURAL, MEP, AND TECHNOLOGY INFRASTRUCTURE TO BE PAINTED WITHIN THOSE EXTENTS.

- RCP REFERENCED NOTES:**
- DASHED LINE INDICATES EXTENT OF ALTERNATE BID #2 TO BUILD-OUT PRODUCTION LAB #001. REFER TO PLAN 2 ON A2.51 FOR SCOPE OF WORK UNDER ALTERNATE BID.
  - PAINT FACE OF GYP. BD. SOFFIT P-8
  - PAINT FACE OF GYP. BD. SOFFIT P-7
  - PAINT FACE OF GYP. BD. SOFFIT P-6
  - PAINT FACE OF SOFFIT P-4
  - PAINT STRUCTURE ABOVE P-4 (NOT USED)
  - PROVIDE 6" METAL PERIMETER TRIM TRANSITION
  - BOUNDARY OF INDIVIDUAL SUSPENDED CEILING TILE GRIDS
  - SURFACE MOUNTED ROLLER SHADE
  - RECESSED ROLLER SHADE
  - DIFFUSERS & DEVICES SHOWN FOR REFERENCE - SUSPEND ABOVE WOOD GRILLE CEILING
  - DISH WASHER EXHAUST DUCT
  - FUTURE T.V./DIGITAL DISPLAY BY USING AGENCY - N.I.C.
  - SECURITY GRILLE LOCATED ABOVE SAT CEILING SYSTEM
  - MOTORIZED PROJECTION SCREEN
  - REMOVE SCRAM AT DIFFUSER LOCATION. MOUNT DIFFUSERS FLUSH WITH BACK OF WOOD SLATS
  - PAINT DIFFUSERS IN FIELD (P-8)
  - HATCH INDICATES AREA OF NEW EIFS SOFFIT. DASHED LINE INDICATES CONTROL JOINT LOCATION
  - REINSTALL EXISTING LIGHT FIXTURES - SEE ELECTRICAL DRAWINGS
  - REINSTALL EXISTING LIGHT FIXTURE - BY E.C.

**RCP SYMBOLS LEGEND:**

NOTE: REFER TO M.E.P. DRAWINGS FOR ADDITIONAL INFORMATION ON MECHANICAL, ELECTRICAL, AND FIRE PROTECTION SYSTEMS

	CEILING TYPE
	CEILING ELEVATION A.F.F.
	SUSPENDED ACOUSTICAL TILE CEILING
	GYP. BOARD CEILING OR SOFFIT
	LINEAR WOOD SLAT CEILING SYSTEM
	WOOD PANEL CEILING
	GREASE EXHAUST HOOD
	PSP MAKE UP DIFFUSER
	RADIANT HEAT PANEL BY H.C.
	ROLLER SHADE (TYP.)
	RECESSED 2'x2' FLUORESCENT LIGHT FIXTURE, BY E.C.
	RECESSED 2'x2' FLUORESCENT FIXTURE, BY E.C.
	RECESSED FLUORESCENT LIGHT LINEAR FIXTURE, BY E.C.
	RECESSED 4'x4' FLUORESCENT LIGHT FIXTURE, BY E.C.
	SURFACE MOUNT 4'x4' FLUORESCENT LIGHT FIXTURE, BY E.C.
	SMALL PENDANT LIGHT FIXTURE, BY E.C.
	RECESSED DOWN LIGHT, BY E.C.
	HEAT LAMP, BY E.C.
	RECESSED DOWN LIGHT, BY E.C.
	PENDANT LIGHT MOUNT FIXTURE, BY E.C.
	PENDANT LIGHT MOUNT LINEAR FIXTURE, BY E.C.
	PENDANT LIGHT MOUNT FIXTURE SMALL, BY E.C.
	PENDANT LIGHT MOUNT FIXTURE LARGE, BY E.C.
	SPRINKLER HEAD, BY SPC
	WALL LIGHT MOUNT FIXTURE, BY E.C.
	PENDANT LIGHT HUNG FLUORESCENT STRIP FIXTURE, BY E.C.
	RECESSED LIGHT LINEAR FLUORESCENT FIXTURE, BY E.C.
	WALL LIGHT MOUNT FLUORESCENT FIXTURE, BY E.C.
	TRACK MOUNT LIGHT FIXTURE, BY E.C.
	SCREEN - FURNISHED BY U.A. INSTALLED BY G.C. - N.I.C.
	CEILING MOUNTED PROJECTOR
	EXIT SIGN - SEE CODE COMPLIANCE PLAN, BY E.C.
	HEAT DETECTOR, BY E.C.
	SMOKE DETECTOR, BY E.C.
	EXISTING SMOKE DETECTOR, RELOCATED BY E.C.
	FIRE ALARM DEVICE, BY E.C.
	SPEAKER, N.I.C.
	CLOSED CIRCUIT CAMERA, VERIFY DIRECTION, BY E.C.
	CAMERA, N.I.C.
	OCCUPANT SENSOR, BY E.C.
	WIRELESS ACCESS POINT, BY E.C.
	VACANCY SENSOR, BY E.C.
	LIGHT SENSOR, BY E.C.
	CORD REEL, BY E.C.
	INDICATES EXISTING FIXTURE
	REMOVE AND RELOCATE EXISTING FIXTURE, BY E.C.
	RETURN AIR GRILLE, BY V.C.
	SUPPLY AIR GRILLE, BY V.C.
	LINEAR DIFFUSER - SUPPLY/RETURN, BY V.C.
	ACCESS PANEL
	CABINET UNIT HEATER OR FAN COIL UNIT, BY H.C.

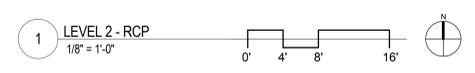

NOTE: CONTRACTOR SHALL VERIFY ALL DIMENSIONS AND CONDITIONS AT JOB SITE AND BE FULLY RESPONSIBLE FOR SAME.

REVISIONS		
NO.	DESCRIPTION	DATE
7	ISSUED FOR CONSTRUCTION	2015-07-31
7	RFPCO G-10, E-4	2016-04-15
9	RFPCO G-20, V-3	2016-05-05
10	RFPCO G-19	2016-05-05

DRAWN	PREPARED	OFF.
TRACED	APPROVED	
CHECKED	APPROVED	

**dkA** DEMONICA KEMPER ARCHITECTS  
125 N. HALSTED STREET, SUITE 307, CHICAGO, IL 60661 P: 312.496.0000

**KJWW ENGINEERING**  
1100 WARRENVILLE ROAD, #400W NAPERVILLE, IL 60563 T: 630.527.2320

**E.F. WHITNEY, INC.**  
568 ANN STREET BIRMINGHAM, MI 48009 T: 248.644.0990

**BOVBD** BOARD OF DEVELOPMENT C B I L L T

State of Illinois  
Pat Quinn, Governor  
Illinois Capital Development Board

**Building a Better Illinois**

**ISSUED FOR CONSTRUCTION**  
**REFLECTED CEILING PLAN - LEVEL 2**

**CITY CENTER CAMPUS**  
**JOLIET JUNIOR COLLEGE**

PROJECT NO. CDB 810-048-023  
DATE DEC. 12, 2014  
SHEET NO. **A2.21** OF SHEETS

CEILING TYPES:	
TYPE	DESCRIPTION
0	EXPOSED STRUCTURE
1	5/8" PAINTED GYP BOARD ON METAL FRAMING
2	2X2 ACOUSTICAL PANEL SYSTEM
3	WOOD GRILL CEILING PANELS - 3/4" x 2 1/4" SLATS ON PAINTED FLAT BACKER W/BLACK FELT BACKER
4	2X2 VINYL-FACED GYP BOARD PANEL CEILING SYSTEM
5	TILE ON DIMENSIONAL BACKER ON METAL FRAMING
6	STAINLESS STEEL PANEL
7	WOOD GRILL CEILING PANELS - 5/8" x 2 1/4" SLATS ON PAINTED FLAT BACKER
8	ACOUSTIC PLASTER ON 5/8" PAINTED GYP BOARD ON METAL FRAMING


- RCP GENERAL NOTES:**
- ALL HEATING, VENTILATION, ELECTRICAL, PLUMBING, AND FIRE PROTECTION ITEMS ARE SHOWN ON ARCHITECTURAL REFLECTED CEILING PLANS FOR REFERENCE AND COORDINATION ONLY. REFER TO HEATING, VENTILATION, ELECTRICAL, PLUMBING, AND FIRE PROTECTION DRAWINGS FOR ACTUAL QUANTITIES. IN CASE OF CONFLICT THE ARCHITECTURAL REFLECTED CEILING PLAN SHALL GOVERN LOCATION OF THESE ITEMS.
  - IN AREAS THAT DO NOT HAVE ARCHITECTURAL REFLECTED CEILING PLANS YET REQUIRE NEW ITEMS TO BE INSTALLED IN OR ABOVE THE CEILING PLANE, CONTRACTOR SHALL REMOVE AND REINSTALL, REPLACE OR MODIFY EXISTING CEILING CONSTRUCTION TO ACCOMMODATE NEW WORK. ANY NEW CEILING AREAS SHALL MATCH EXISTING ADJACENT FINISHES.
  - CENTER ALL FIXTURES IN CEILING TILES AND FIELD VERIFY GRID LAYOUT FOR PROPER FIXTURE LOCATION. ALIGN ALL FIXTURES IN BOTH DIRECTIONS OF CEILING TILE (LINO).
  - CENTER ALL SPRINKLER HEADS IN CEILING TILES.
  - ALL GYP. BD. CEILINGS TO BE PAINTED P-2 UNLESS OTHERWISE NOTED ON PLANS.
  - EXTEND FACE OF ALL GYP. BD. SOFFITS AND HEADERS 4" MIN. BEYOND FINISHED CEILING ABOVE U.L.O.
  - WHERE CEILING TYPE IS SPECIFIED AND AN ASSOCIATED PAINT COLOR IS INDICATED ON THE RCP, ALL STRUCTURAL, MEP, AND TECHNOLOGY INFRASTRUCTURE TO BE PAINTED WITHIN THOSE EXTENTS.

- RCP REFERENCED NOTES:**
- DASHED LINE INDICATES EXTENT OF ALTERNATE BID #2 TO BUILD-OUT PRODUCTION LAB 5001. REFER TO PLAN 2 OR A2.31 FOR SCOPE OF WORK UNDER ALTERNATE BID.
  - PAINT FACE OF GYP. BD. SOFFIT P-8
  - PAINT FACE OF GYP. BD. SOFFIT P-7
  - PAINT FACE OF GYP. BD. SOFFIT P-6
  - PAINT FACE OF SOFFIT P-4
  - STRUCTURE ABOVE P-4 (NOT USED)
  - BOUNDARY OF INDIVIDUAL SUSPENDED CEILING TILES
  - BOUNDARY OF METAL PERIMETER TRIM TRANSITION
  - SURFACE MOUNTED ROLLER SHADE
  - RECESSED ROLLER SHADE
  - DIFFUSERS & DEVICES SHOWN FOR REFERENCE - SUSPEND ABOVE WOOD GRILLE CEILING
  - DISH WASHER EXHAUST DUCT
  - FUTURE T.V./DIGITAL DISPLAY, BY USING AGENCY - N.I.C.
  - SECURITY GRILLE LOCATED ABOVE SAT CEILING SYSTEM
  - MOTORIZED PROJECTION SCREEN
  - REMOVE SCRM AT DIFFUSER LOCATION. MOUNT DIFFUSERS FLUSH WITH BACK OF WOOD SLATS
  - PAINT DIFFUSERS IN FIELD (P-8)
  - MATCH INDICATES AREA OF NEW ERFS SOFFIT. DASHED LINE INDICATES CONTROL JOINT LOCATION. E. C. TO REINSTALL EXISTING LIGHT FIXTURES - SEE ELECTRICAL DRAWINGS.
  - REINSTALL EXISTING LIGHT FIXTURE - BY E. C.

**RCP SYMBOLS LEGEND:**

NOTE: REFER TO M.E.P. DRAWINGS FOR ADDITIONAL INFORMATION ON MECHANICAL, ELECTRICAL, AND FIRE PROTECTION SYSTEMS

	CEILING TYPE
	CEILING ELEVATION A.F.F.
	SUSPENDED ACOUSTICAL TILE CEILING
	GYP. BOARD CEILING OR SOFFIT
	LINEAR WOOD SLAT CEILING SYSTEM
	WOOD PANEL CEILING
	GREASE EXHAUST HOOD
	PSP MAKE UP DIFFUSER
	RADIANT HEAT PANEL, BY H.C.
	ROLLER SHADE (TYP.)
	RECESSED 2x4 FLUORESCENT LIGHT FIXTURE, BY E.C.
	RECESSED 2x2 FLUORESCENT FIXTURE, BY E.C.
	RECESSED FLUORESCENT LIGHT LINEAR FIXTURE, BY E.C.
	RECESSED 4x4 FLUORESCENT LIGHT FIXTURE, BY E.C.
	SURFACE MOUNT 4x4 FLUORESCENT LIGHT FIXTURE, BY E.C.
	SMALL PENDANT LIGHT FIXTURE, BY E.C.
	RECESSED DOWN LIGHT, BY E.C.
	HEAT LAMP, BY E.C.
	RECESSED DOWN LIGHT, BY E.C.
	PENDANT LIGHT MOUNT FIXTURE, BY E.C.
	PENDANT LIGHT MOUNT LINEAR FIXTURE, BY E.C.
	PENDANT LIGHT MOUNT FIXTURE SMALL, BY E.C.
	PENDANT LIGHT MOUNT FIXTURE LARGE, BY E.C.
	SPRINKLER HEAD, BY SPC
	WALL LIGHT MOUNT FIXTURE, BY E.C.
	PENDANT LIGHT HUNG FLUORESCENT STRIP FIXTURE, BY E.C.
	RECESSED LIGHT LINEAR FLUORESCENT FIXTURE, BY E.C.
	WALL LIGHT MOUNT FLUORESCENT FIXTURE, BY E.C.
	TRACK MOUNT LIGHT FIXTURE, BY E.C.
	SCREEN - FURNISHED BY UA, INSTALLED BY G.C. - N.I.C.
	CEILING MOUNTED PROJECTOR
	EXIT SIGN - SEE CODE COMPLIANCE PLAN, BY E.C.
	HEAT DETECTOR, BY E.C.
	SMOKE DETECTOR, BY E.C.
	EXISTING SMOKE DETECTOR, RELOCATED BY E.C.
	FIRE ALARM DEVICE, BY E.C.
	SPEAKER, N.I.C.
	CLOSED CIRCUIT CAMERA, VERIFY DIRECTION, BY E.C.
	CAMERA, N.I.C.
	OCCUPANT SENSOR, BY E.C.
	WIRELESS ACCESS POINT, BY E.C.
	VACANCY SENSOR, BY E.C.
	LIGHT SENSOR, BY E.C.
	CORD REEL, BY E.C.
	INDICATES EXISTING FIXTURE
	REMOVE AND RELOCATE EXISTING FIXTURE, BY E.C.
	RETURN AIR GRILLE, BY V.C.
	SUPPLY AIR GRILLE, BY V.C.
	LINEAR DIFFUSER - SUPPLY/RETURN, BY V.C.
	ACCESS PANEL
	CABINET UNIT HEATER OR FAN COIL UNIT, BY H.C.

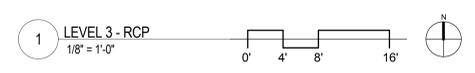

NOTE: CONTRACTOR SHALL VERIFY ALL DIMENSIONS AND CONDITIONS AT JOB SITE AND BE FULLY RESPONSIBLE FOR SAME.

REVISIONS		
NO.	DESCRIPTION	DATE
7	ISSUED FOR CONSTRUCTION	2015-07-31
10	ISSUED FOR CONSTRUCTION	2016-04-15
10	ISSUED FOR CONSTRUCTION	2016-05-05

DEMONICA KEMPER ARCHITECTS

DEMONICA KEMPER ARCHITECTS

KJWW ENGINEERING

E.F. WHITNEY, INC.

State of Illinois

Pat Quinn, Governor

Illinois Capital Development Board

Building a Better Illinois

State of Illinois  
 Pat Quinn, Governor  
 Illinois Capital Development Board

ISSUED FOR CONSTRUCTION

REFLECTED CEILING PLAN - LEVEL 3

CITY CENTER CAMPUS JOLIET JUNIOR COLLEGE

PROJECT NO. CDB 810-048-023  
 DATE DEC. 12, 2014  
 SHEET NO. A2.31 OF SHEETS

CEILING TYPES:	
TYPE	DESCRIPTION
0	EXPOSED STRUCTURE
1	5/8" PAINTED GYP BOARD ON METAL FRAMING
2	2X2 ACOUSTICAL PANEL SYSTEM
3	WOOD GRILL CEILING PANELS - 3/4" x 2 1/4" SLATS ON PAINTED FLAT BACKER W BLACK FELT BACKER
4	2X2 VINYL-FACED GYP BOARD PANEL CEILING SYSTEM
5	TILE ON CEMENTITIOUS BACKER ON METAL FRAMING
6	STAINLESS STEEL PANEL
7	WOOD GRILL CEILING PANELS - 5/8" x 2 1/4" SLATS ON PAINTED FLAT BACKER
8	ACOUSTIC PLASTER ON 5/8" PAINTED GYP BOARD ON METAL FRAMING



- RCP GENERAL NOTES:**
- ALL HEATING, VENTILATION, ELECTRICAL, PLUMBING, AND FIRE PROTECTION ITEMS ARE SHOWN ON ARCHITECTURAL REFLECTED CEILING PLANS FOR REFERENCE AND COORDINATION ONLY. REFER TO HEATING, VENTILATION, ELECTRICAL, PLUMBING, AND FIRE PROTECTION DRAWINGS FOR ACTUAL QUANTITIES. IN CASE OF CONFLICT THE ARCHITECTURAL REFLECTED CEILING PLAN SHALL GOVERN LOCATION OF THESE ITEMS.
  - IN AREAS THAT DO NOT HAVE ARCHITECTURAL REFLECTED CEILING PLANS YET REQUIRE NEW ITEMS TO BE INSTALLED IN OR ABOVE THE CEILING PLANE, CONTRACTOR SHALL REMOVE AND REINSTALL, REPLACE OR MODIFY EXISTING CEILING CONSTRUCTION TO ACCOMMODATE NEW WORK. ANY NEW CEILING AREAS SHALL MATCH EXISTING ADJACENT FINISHES.
  - CENTER ALL FIXTURES IN CEILING TILES AND FIELD VERIFY GRID LAYOUT FOR PROPER FIXTURE LOCATION. ALIGN ALL FIXTURES IN BOTH DIRECTIONS OF CEILING TILE (UNO).
  - CENTER ALL SPRINKLER HEADS IN CEILING TILES.
  - ALL GYP. BD. CEILINGS TO BE PAINTED P-2 UNLESS OTHERWISE NOTED ON PLANS.
  - EXTEND FACE OF ALL GYP. BD. SOFFITS AND HEADERS 4" MIN. BEYOND FINISHED CEILING ABOVE UNO.
  - WHERE CEILING TYPE D IS SPECIFIED AND AN ASSOCIATED PAINT COLOR IS INDICATED ON THE RCP, ALL STRUCTURAL, MEP, AND TECHNOLOGY INFRASTRUCTURE TO BE PAINTED WITHIN THOSE EXTENTS.

- RCP REFERENCED NOTES:**
- DASHED LINE INDICATES EXTENT OF ALTERNATE BID #2 TO BUILD-OUT PRODUCTION LAB 5001. REFER TO PLAN 2 ON A2.51 FOR SCOPE OF WORK UNDER ALTERNATE BID.
  - PAINT FACE OF GYP. BD. SOFFIT P-8
  - PAINT FACE OF GYP. BD. SOFFIT P-7
  - PAINT FACE OF GYP. BD. SOFFIT P-6
  - PAINT FACE OF SOFFIT P-4
  - PAINT STRUCTURE ABOVE P-4 (NOT USED)
  - PROVIDE 6" METAL PERIMETER TRIM TRANSITION
  - BOUNDARY OF INDIVIDUAL SUSPENDED CEILING TILE GRIDS
  - SURFACE MOUNTED ROLLER SHADE
  - RECESSED ROLLER SHADE
  - DIFFUSERS & DEVICES SHOWN FOR REFERENCE - SUSPEND ABOVE WOOD GRILLE CEILING
  - DISH WASHER EXHAUST DUCT
  - FUTURE T.V./DIGITAL DISPLAY BY USING AGENCY - N.I.C.
  - SECURITY GRILLE LOCATED ABOVE SAT CEILING SYSTEM
  - MOTORIZED PROJECTION SCREEN
  - REMOVE SCRIM AT DIFFUSER LOCATION. MOUNT DIFFUSERS FLUSH WITH BACK OF WOOD SLATS
  - PANT DIFFUSERS IN FIELD (P-8)
  - HATCH INDICATES AREA OF NEW GYP. SOFFIT. DASHED LINE INDICATES CONTROL JOINT LOCATION.
  - TO REINSTALL EXISTING LIGHT FIXTURES - SEE ELECTRICAL DRAWINGS.
  - REINSTALL EXISTING LIGHT FIXTURE - BY E.C.

**RCP SYMBOLS LEGEND:**


NOTE: REFER TO M.E.P.F.P. DRAWINGS FOR ADDITIONAL INFORMATION ON MECHANICAL, ELECTRICAL, AND FIRE PROTECTION SYSTEMS

	CEILING TYPE
	CEILING ELEVATION A.F.F.
	SUSPENDED ACOUSTICAL TILE CEILING
	GYP. BOARD CEILING OR SOFFIT
	LINEAR WOOD SLAT CEILING SYSTEM
	WOOD PANEL CEILING
	GREASE EXHAUST HOOD
	PSP MAKE UP DIFFUSER
	RADIANT HEAT PANEL, BY H.C.
	ROLLER SHADE (TYP.)
	RECESSED 2x2 FLUORESCENT LIGHT FIXTURE, BY E.C.
	RECESSED 2x2 FLUORESCENT FIXTURE, BY E.C.
	RECESSED FLUORESCENT LIGHT LINEAR FIXTURE, BY E.C.
	RECESSED 4x4 FLUORESCENT LIGHT FIXTURE, BY E.C.
	SURFACE MOUNT 4x4 FLUORESCENT LIGHT FIXTURE, BY E.C.
	SMALL PENDANT LIGHT FIXTURE, BY E.C.
	RECESSED DOWN LIGHT, BY E.C.
	HEAT LAMP, BY E.C.
	RECESSED DOWN LIGHT, BY E.C.
	PENDANT LIGHT MOUNT FIXTURE, BY E.C.
	PENDANT LIGHT MOUNT LINEAR FIXTURE, BY E.C.
	PENDANT LIGHT MOUNT FIXTURE SMALL, BY E.C.
	PENDANT LIGHT MOUNT FIXTURE LARGE, BY E.C.
	SPRINKLER HEAD, BY SPC
	WALL LIGHT MOUNT FIXTURE, BY E.C.
	PENDANT LIGHT HUNG FLUORESCENT STRIP FIXTURE, BY E.C.
	RECESSED LIGHT LINEAR FLUORESCENT FIXTURE, BY E.C.
	WALL LIGHT MOUNT FLUORESCENT FIXTURE, BY E.C.
	TRACK MOUNT LIGHT FIXTURE, BY E.C.
	SCREEN - FURNISHED BY U.A. INSTALLED BY G.C. - N.I.C.
	CEILING MOUNTED PROJECTOR
	EXIT SIGN- SEE CODE COMPLIANCE PLAN, BY E.C.
	HEAT DETECTOR, BY E.C.
	SMOKE DETECTOR, BY E.C.
	EXISTING SMOKE DETECTOR, RELOCATED BY E.C.
	FIRE ALARM DEVICE, BY E.C.
	SPEAKER, N.I.C.
	CLOSED CIRCUIT CAMERA, VERIFY DIRECTION, BY E.C.
	CAMERA, N.I.C.
	OCCUPANT SENSOR, BY E.C.
	WIRELESS ACCESS POINT, BY E.C.
	VACANCY SENSOR, BY E.C.
	LIGHT SENSOR, BY E.C.
	CORD REEL, BY E.C.
	INDICATES EXISTING FIXTURE
	REMOVE AND RELOCATE EXISTING FIXTURE, BY E.C.
	RETURN AIR GRILLE, BY V.C.
	SUPPLY AIR GRILLE, BY V.C.
	LINEAR DIFFUSER - SUPPLY/RETURN, BY V.C.
	ACCESS PANEL
	CABINET UNIT HEATER OR FAN COIL UNIT, BY H.C.

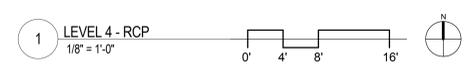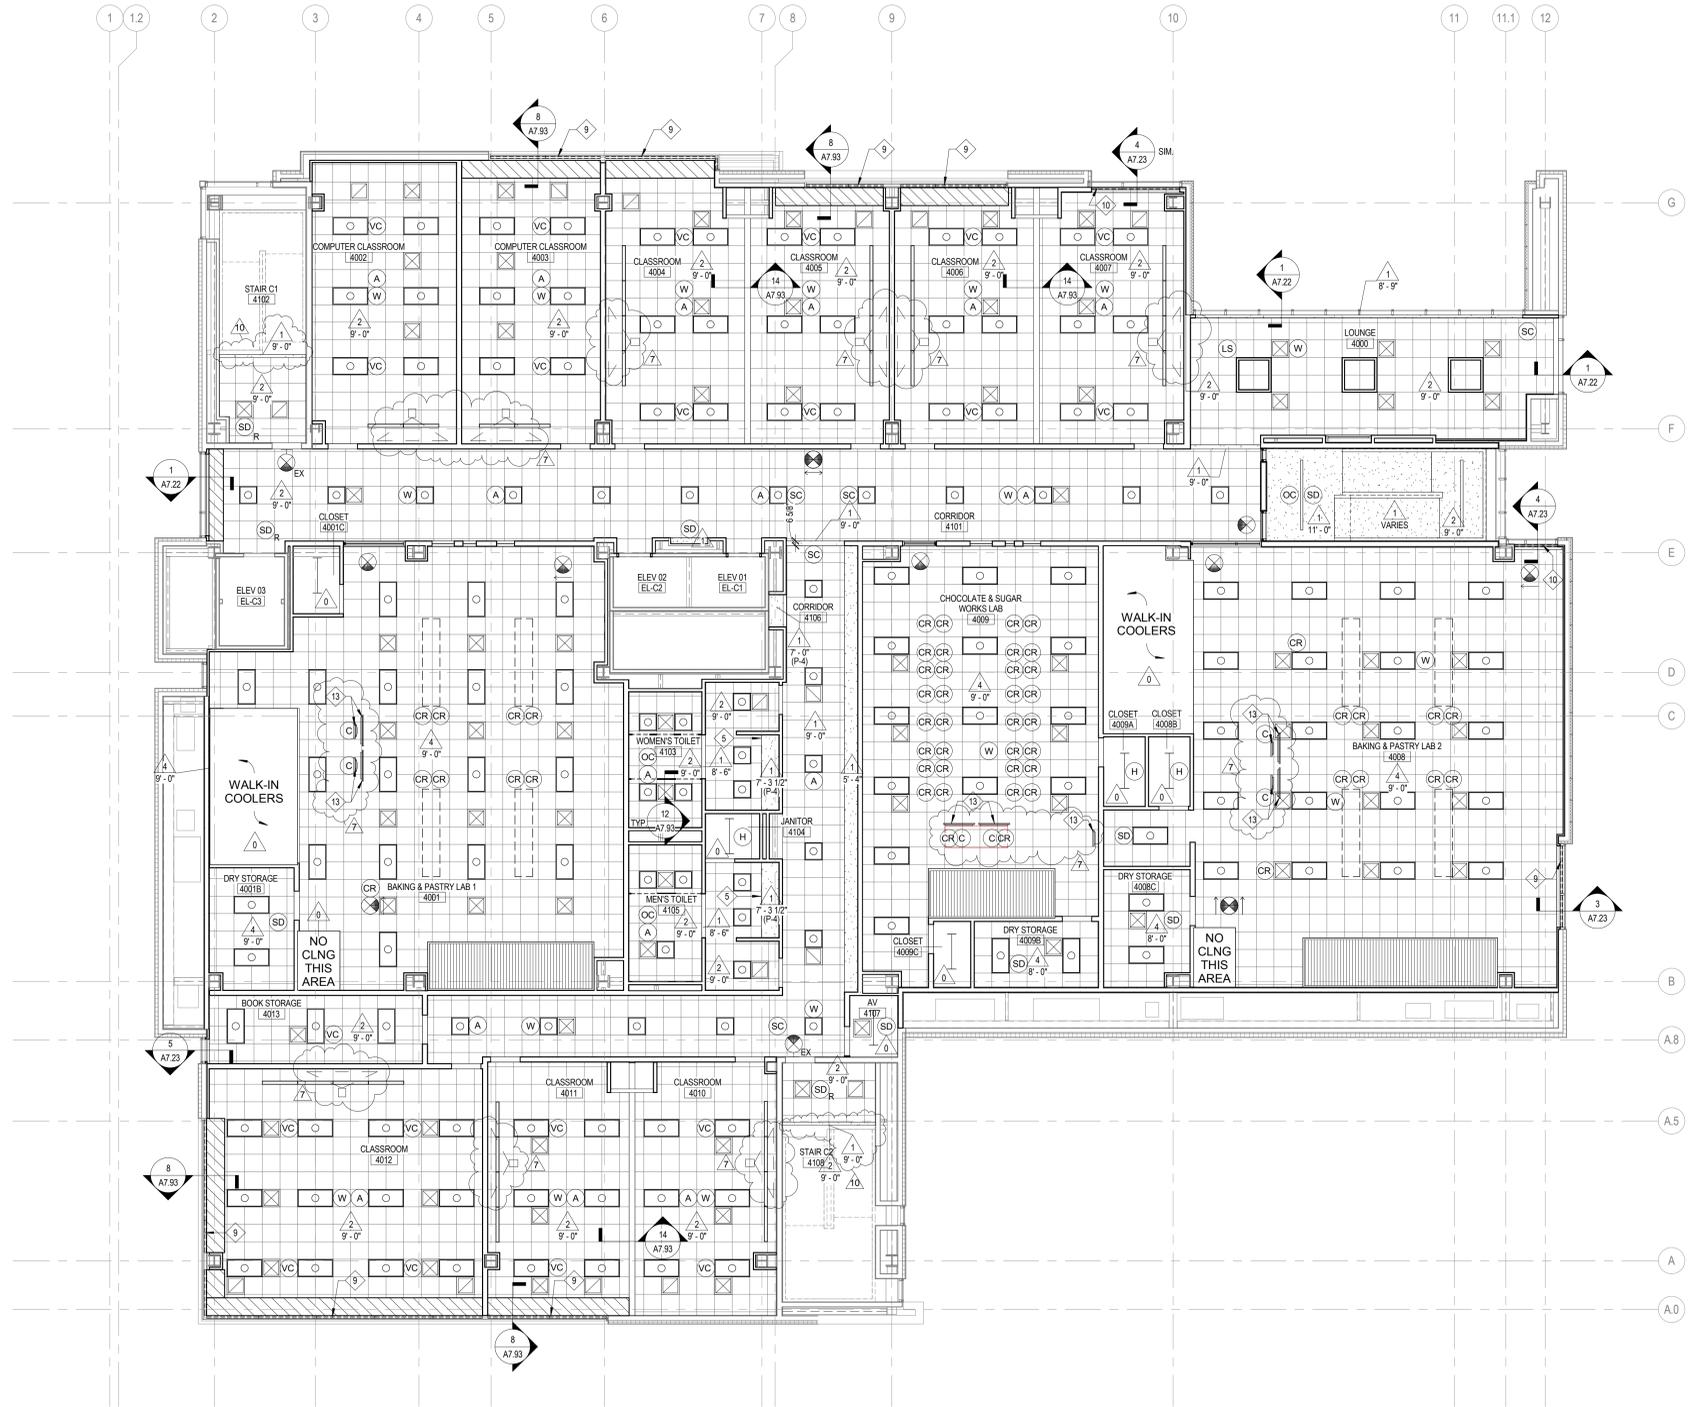

NOTE: CONTRACTOR SHALL VERIFY ALL DIMENSIONS AND CONDITIONS AT JOB SITE AND BE FULLY RESPONSIBLE FOR SAME.

REVISIONS		
NO.	DESCRIPTION	DATE
7	ISSUED FOR CONSTRUCTION	2015-07-31
10	RFP CD G-10, E-4	2016-04-15
	RFP CD G-19	2016-05-05

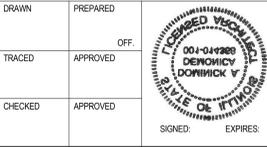

**demonica kemper ARCHITECTS**  
 125 N. HALSTED STREET, SUITE 301  
 CHICAGO, IL 60661  
 P: 312.496.0000


**KJWW ENGINEERING**  
 1100 WARRENVILLE ROAD, #400W NAPERVILLE, IL 60563  
 T: 630.527.2320

**E.F. WHITNEY, INC.**  
 568 ANN STREET BIRMINGHAM, MI 48009  
 T: 248.644.0990



**BOYD DELIORDAWAY CIVIL**  
 State of Illinois  
 Pat Quinn, Governor  
 Illinois Capital Development Board

ISSUED FOR CONSTRUCTION	
<b>REFLECTED CEILING PLAN - LEVEL 4</b>	
<b>CITY CENTER CAMPUS</b>	<b>JOLIET JUNIOR COLLEGE</b>
PROJECT NO. CDB 810-048-023	DATE DEC. 12, 2014
SHEET NO. <b>A2.41</b> OF SHEETS	

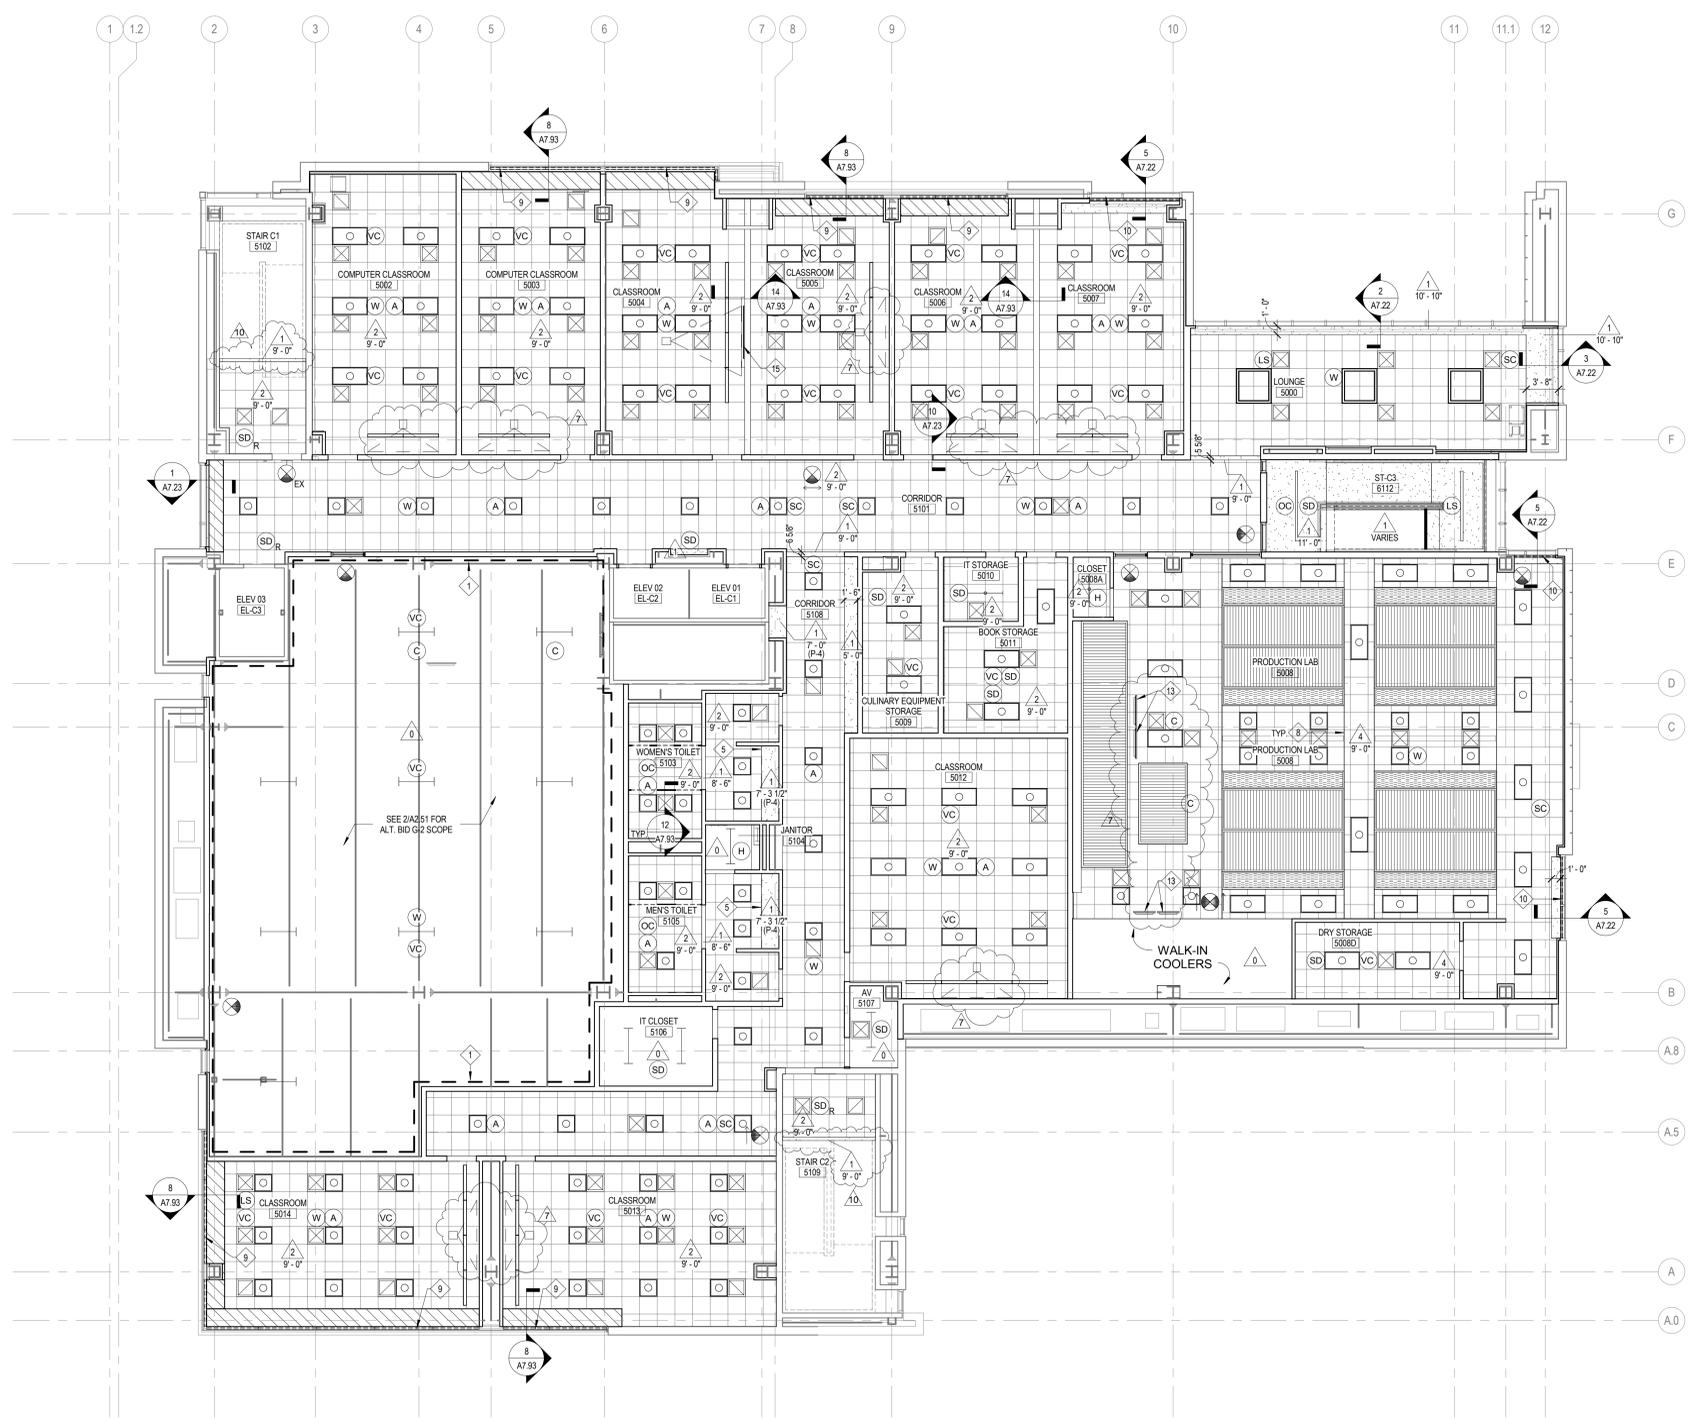

1 LEVEL 5 - RCP  
1/8" = 1'-0"

TYPE	DESCRIPTION
0	EXPOSED STRUCTURE
1	5/8" PARTED GYP BOARD ON METAL FRAMING
2	2X2 ACOUSTICAL PANEL SYSTEM
3	WOOD GRILL CEILING PANELS - 3/4" x 2 1/4" SLATS ON PAINTED FLAT BACKER W BLACK FELT BACKER
4	2X2 VINYL-FACED GYP BOARD PANEL CEILING SYSTEM
5	TILE ON CEMENTITIOUS BACKER ON METAL FRAMING
6	STAINLESS STEEL PANEL
7	WOOD GRILL CEILING PANELS - 5/8" x 2 1/4" SLATS ON PAINTED FLAT BACKER
8	ACOUSTIC PLASTER ON 5/8" PAINTED GYP BOARD ON METAL FRAMING


- RCP GENERAL NOTES:**
- ALL HEATING, VENTILATION, ELECTRICAL, PLUMBING, AND FIRE PROTECTION ITEMS ARE SHOWN ON ARCHITECTURAL REFLECTED CEILING PLANS FOR REFERENCE AND COORDINATION ONLY. REFER TO HEATING, VENTILATION, ELECTRICAL, PLUMBING AND FIRE PROTECTION DRAWINGS FOR ACTUAL QUANTITIES. IN CASE OF CONFLICT THE ARCHITECTURAL REFLECTED CEILING PLAN SHALL GOVERN LOCATION OF THESE ITEMS.
  - IN AREAS THAT DO NOT HAVE ARCHITECTURAL REFLECTED CEILING PLANS YET REQUIRE NEW ITEMS TO BE INSTALLED IN OR ABOVE THE CEILING PLANE, CONTRACTOR SHALL REMOVE AND REINSTALL, REPLACE OR MODIFY EXISTING CEILING CONSTRUCTION TO ACCOMMODATE NEW WORK. ANY NEW CEILING AREAS SHALL MATCH EXISTING ADJACENT FINISHES.
  - CENTER ALL FIXTURES IN CEILING TILES AND FIELD VERIFY GRID LAYOUT FOR PROPER FIXTURE LOCATION. ALIGN ALL FIXTURES IN BOTH DIRECTIONS OF CEILING TILE (UNO).
  - CENTER ALL SPRINKLER HEADS IN CEILING TILES.
  - ALL GYP. BD. CEILINGS TO BE PAINTED P-2 UNLESS OTHERWISE NOTED ON PLANS.
  - EXTEND FACE OF ALL GYP. BD. SOFFITS AND HEADERS 4" MIN. BEYOND FINISHED CEILING ABOVE U.L.D.
  - WHERE CEILING TYPE 0 IS SPECIFIED AND AN ASSOCIATED PAINT COLOR IS INDICATED ON THE RCP, ALL STRUCTURAL, MEP, AND TECHNOLOGY INFRASTRUCTURE TO BE PAINTED WITHIN THOSE EXTENTS.

- RCP REFERENCED NOTES:**
- DASHED LINE INDICATES EXTENT OF ALTERNATE BID #2 TO BUILD-OUT PRODUCTION LAB 5001. REFER TO PLAN 2 ON K-2.51 FOR SCOPE OF WORK UNDER ALTERNATE BID.
  - PAINT FACE OF GYP. BD. SOFFIT P-8
  - PAINT FACE OF GYP. BD. SOFFIT P-2
  - PAINT FACE OF GYP. BD. SOFFIT P-4
  - PAINT FACE OF SOFFIT P-4
  - PAINT STRUCTURE ABOVE P-4 (NOT USED)
  - BOUNDARY OF INDIVIDUAL SUSPENDED CEILING TILE GRIDS
  - SURFACE MOUNTED ROLLER SHADE
  - RECESSED ROLLER SHADE
  - DIFFUSERS & DEVICES SHOWN FOR REFERENCE - SUSPEND ABOVE WOOD GRILLE CEILING
  - DISH WASHER EXHAUST DUCT
  - FUTURE T.V./DIGITAL DISPLAY, BY USING AGENCY - N.I.C.
  - SECURITY GRILLE LOCATED ABOVE SAT CEILING SYSTEM
  - MOTORIZED PROJECTION SCREEN
  - REMOVE SCRM AT DIFFUSER LOCATION. MOUNT DIFFUSERS FLUSH WITH BACK OF WOOD SLATS
  - PAINT DIFFUSERS IN FIELD (P-8)
  - HATCH INDICATES AREA OF NEW EIFS SOFFIT. DASHED LINE INDICATES CONTROL JOINT LOCATION. E. C. TO REINSTALL EXISTING LIGHT FIXTURES - SEE ELECTRICAL DRAWINGS.
  - REINSTALL EXISTING LIGHT FIXTURE - BY E. C.

**RCP SYMBOLS LEGEND:**

NOTE: REFER TO M.E.P.P. DRAWINGS FOR ADDITIONAL INFORMATION ON MECHANICAL, ELECTRICAL, AND FIRE PROTECTION SYSTEMS

- CEILING TYPE
- CEILING ELEVATION A.F.F.
- SUSPENDED ACOUSTICAL TILE CEILING
- GYP/UM BOARD CEILING OR SOFFIT
- LINEAR WOOD SLAT CEILING SYSTEM
- WOOD PANEL CEILING
- GREASE EXHAUST HOOD
- PSP MAKE UP DIFFUSER
- RADIANT HEAT PANEL, BY H.C.
- ROLLER SHADE (TYP.)
- RECESSED 2'x4' FLUORESCENT LIGHT FIXTURE, BY E.C.
- RECESSED 2'x2' FLUORESCENT FIXTURE, BY E.C.
- RECESSED FLUORESCENT LIGHT LINEAR FIXTURE, BY E.C.
- RECESSED 4'x4' FLUORESCENT LIGHT FIXTURE, BY E.C.
- SURFACE MOUNT 4'x4' FLUORESCENT LIGHT FIXTURE, BY E.C.
- SMALL PENDANT LIGHT FIXTURE, BY E.C.
- RECESSED DOWN LIGHT, BY E.C.
- HEAT LAMP, BY E.C.
- RECESSED DOWN LIGHT, BY E.C.
- PENDANT LIGHT MOUNT FIXTURE, BY E.C.
- PENDANT LIGHT MOUNT LINEAR FIXTURE, BY E.C.
- PENDANT LIGHT MOUNT FIXTURE SMALL, BY E.C.
- PENDANT LIGHT MOUNT FIXTURE LARGE, BY E.C.
- SPRINKLER HEAD, BY SPC
- WALL LIGHT MOUNT FIXTURE, BY E.C.
- PENDANT LIGHT HUNG FLUORESCENT STRIP FIXTURE, BY E.C.
- RECESSED LIGHT LINEAR FLUORESCENT FIXTURE, BY E.C.
- WALL LIGHT MOUNT FLUORESCENT FIXTURE, BY E.C.
- TRACK MOUNT LIGHT FIXTURE, BY E.C.
- SCREEN - FURNISHED BY UA, INSTALLED BY G.C. - N.I.C.
- CEILING MOUNTED PROJECTOR
- EXIT SIGN - SEE CODE COMPLIANCE PLAN, BY E.C.
- HEAT DETECTOR, BY E.C.
- SMOKE DETECTOR, BY E.C.
- EXISTING SMOKE DETECTOR, RELOCATED BY E.C.
- FIRE ALARM DEVICE, BY E.C.
- SPEAKER, N.I.C.
- CLOSED CIRCUIT CAMERA, VERIFY DIRECTION, BY E.C.
- CAMERA, N.I.C.
- OCCUPANT SENSOR, BY E.C.
- WIRELESS ACCESS POINT, BY E.C.
- VACANCY SENSOR, BY E.C.
- LIGHT SENSOR, BY E.C.
- CORD REEL, BY E.C.
- INDICATES EXISTING FIXTURE
- REMOVE AND RELOCATE EXISTING FIXTURE, BY E.C.
- RETURN AIR GRILLE, BY V.C.
- SUPPLY AIR GRILLE, BY V.C.
- LINEAR DIFFUSER - SUPPLY/RETURN, BY V.C.
- ACCESS PANEL
- CABINET UNIT HEATER OR FAN COIL UNIT, BY H.C.

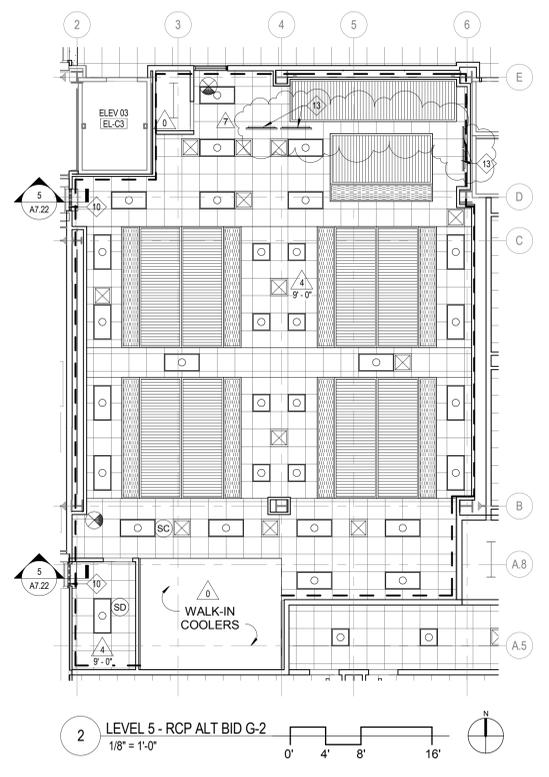

NOTE: CONTRACTOR SHALL VERIFY ALL DIMENSIONS AND CONDITIONS AT JOB SITE AND BE FULLY RESPONSIBLE FOR SAME.

REVISIONS			DRAWN	PREPARED	OFF.
NO.	DESCRIPTION	DATE			
7	ISSUED FOR CONSTRUCTION	2015-07-31			
	RFP CD G-10, E-4	2016-04-15			
10	RFP CD G-19	2016-05-05			
			CHECKED	APPROVED	

**dkA** DEMONICA KEMPER ARCHITECTS  
125 N. HALSTED STREET, SUITE 301  
CHICAGO, IL 60661  
P: 312.496.0000

**KJWW** ENGINEERING  
1100 WARRENVILLE ROAD, #400W NAPERVILLE, IL 60563  
T: 630.527.2320

**E.F. WHITNEY, INC.**  
568 ANN STREET BIRMINGHAM, MI 48009  
T: 248.644.0990

**BOYD DEVELOPMENT CONSULTANTS**

State of Illinois  
Pat Quinn, Governor  
Illinois Capital Development Board



Building a Better Illinois

**ISSUED FOR CONSTRUCTION**

**REFLECTED CEILING PLAN - LEVEL 5**

**CITY CENTER CAMPUS JOLIET JUNIOR COLLEGE**

PROJECT NO. CDB 810-048-023  
DATE DEC. 12, 2014  
SHEET NO. **A2.51** OF SHEETS

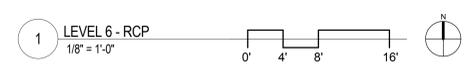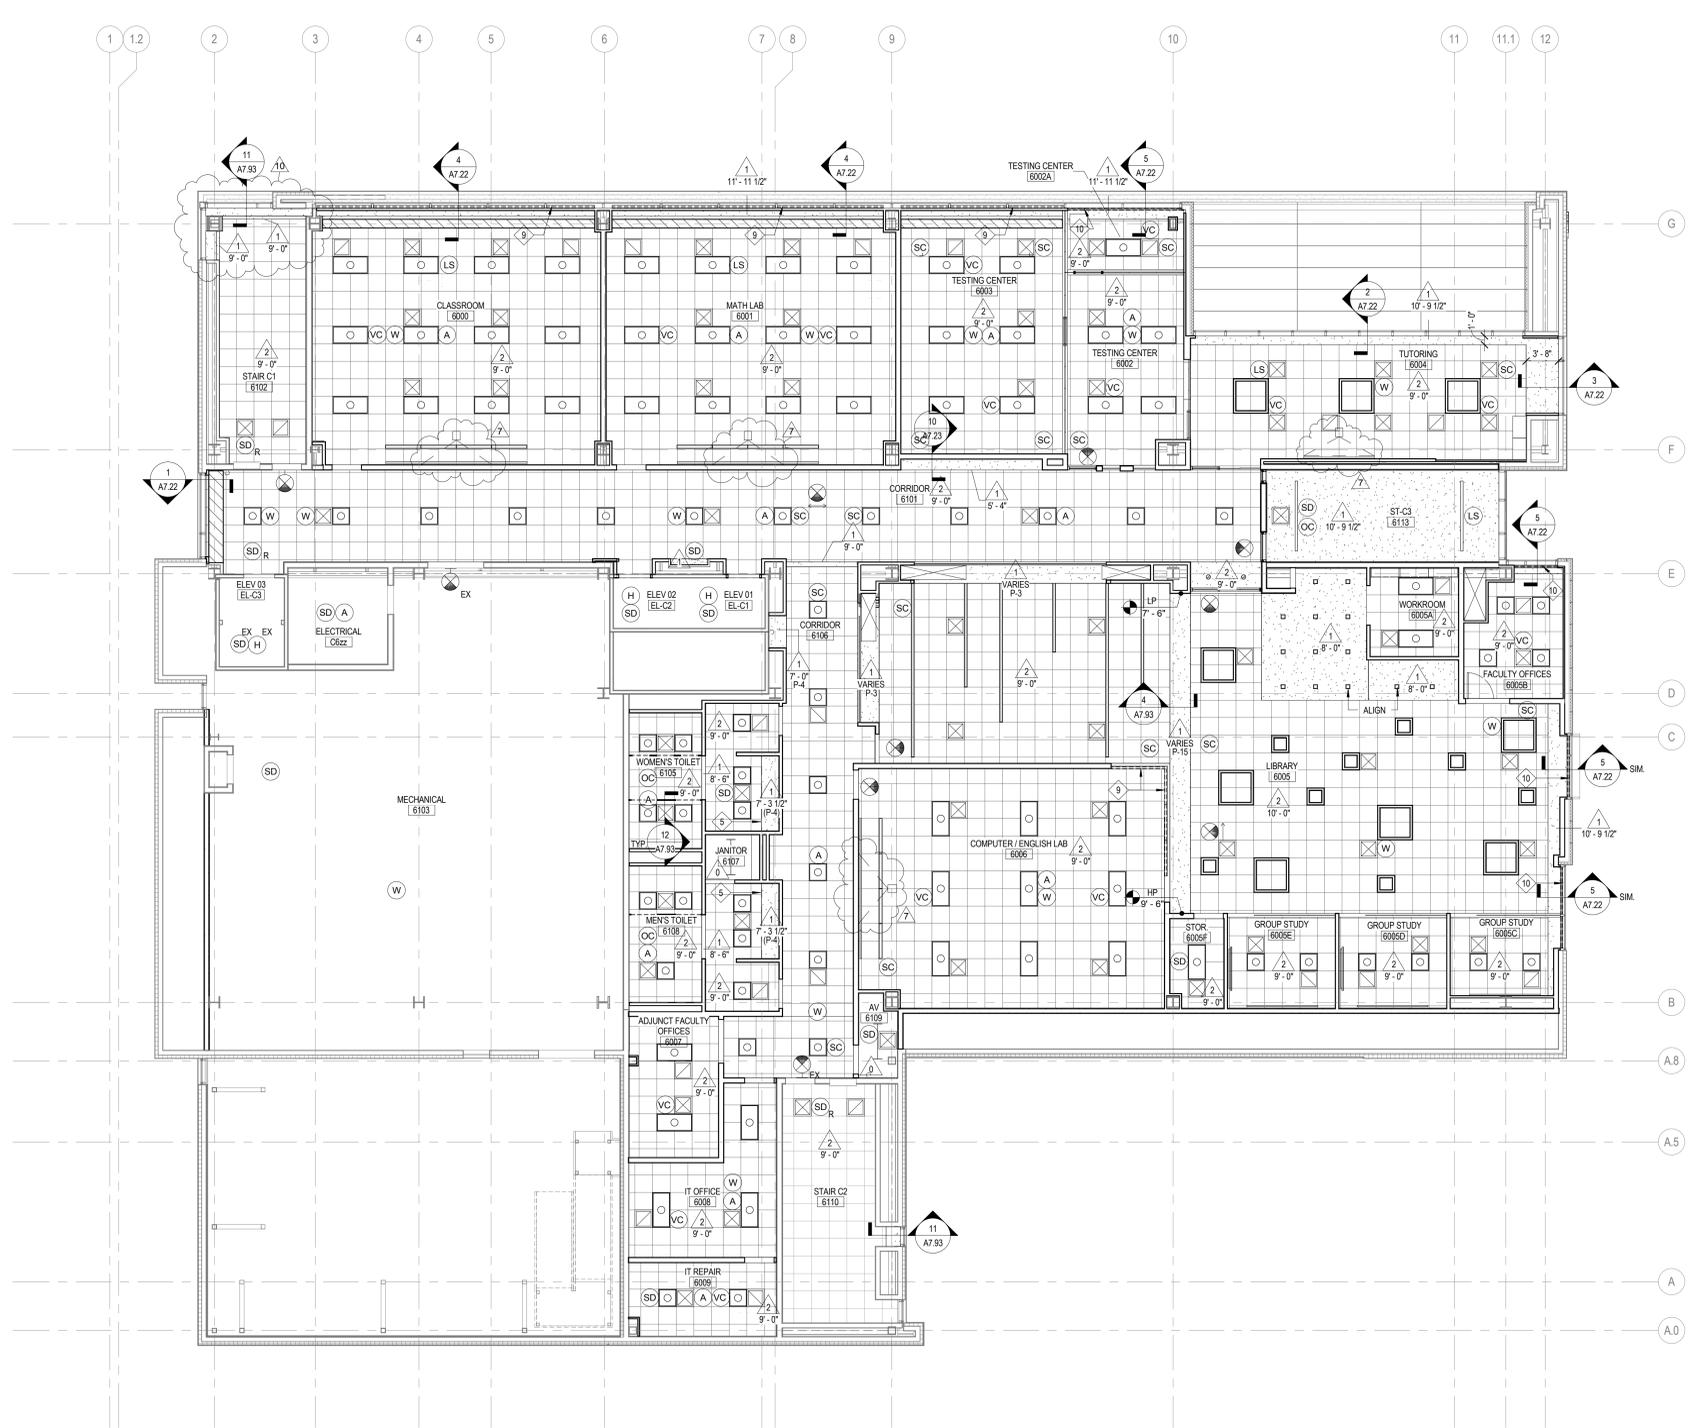

CEILING TYPES:	
TYPE	DESCRIPTION
0	EXPOSED STRUCTURE
1	5/8" PAINTED GYP BOARD ON METAL FRAMING
2	2X2 ACOUSTICAL PANEL SYSTEM
3	WOOD GRILL CEILING PANELS - 3/4" x 2 1/4" SLATS ON PAINTED FLAT BACKER W/ BLACK FELT BACKER
4	2X2 VINYL-FACED GYP BOARD PANEL CEILING SYSTEM
5	TILE ON CEMENTITIOUS BACKER ON METAL FRAMING
6	STAINLESS STEEL PANEL
7	WOOD GRILL CEILING PANELS - 5/8" x 2 1/4" SLATS ON PAINTED FLAT BACKER
8	ACOUSTIC PLASTER ON 5/8" PAINTED GYP BOARD ON METAL FRAMING

- RCP GENERAL NOTES:**
- ALL HEATING, VENTILATION, ELECTRICAL, PLUMBING, AND FIRE PROTECTION ITEMS ARE SHOWN ON ARCHITECTURAL REFLECTED CEILING PLANS FOR REFERENCE AND COORDINATION ONLY. REFER TO HEATING, VENTILATION, ELECTRICAL, PLUMBING, AND FIRE PROTECTION DRAWINGS FOR ACTUAL QUANTITIES. IN CASE OF CONFLICT THE ARCHITECTURAL REFLECTED CEILING PLAN SHALL GOVERN LOCATION OF THESE ITEMS.
  - IN AREAS THAT DO NOT HAVE ARCHITECTURAL REFLECTED CEILING PLANS YET REQUIRE NEW ITEMS TO BE INSTALLED IN OR ABOVE THE CEILING PLANE, CONTRACTOR SHALL REMOVE AND REINSTALL, REPLACE OR MODIFY EXISTING CEILING CONSTRUCTION TO ACCOMMODATE NEW WORK. ANY NEW CEILING AREAS SHALL MATCH EXISTING ADJACENT FINISHES.
  - CENTER ALL FIXTURES IN CEILING TILES AND FIELD VERIFY GRID LAYOUT FOR PROPER FIXTURE LOCATION. ALIGN ALL FIXTURES IN BOTH DIRECTIONS OF CEILING TILE. (L/N)
  - CENTER ALL SPRINKLER HEADS IN CEILING TILES.
  - ALL GYP. BD. CEILINGS TO BE PAINTED P-2 UNLESS OTHERWISE NOTED ON PLANS
  - EXTEND FACE OF ALL GYP. BD. SOFFITS AND HEADERS 4" MIN. BEYOND FINISHED CEILING ABOVE U.N.O.
  - WHERE CEILING TYPE IS SPECIFIED AND AN ASSOCIATED PAINT COLOR IS INDICATED ON THE RCP, ALL STRUCTURAL, MEP, AND TECHNOLOGY INFRASTRUCTURE TO BE PAINTED WITHIN THOSE EXTENTS.

- RCP REFERENCED NOTES:**
- DASHED LINE INDICATES EXTENT OF ALTERNATE BID #2 TO BUILD-OUT PRODUCTION LAB 501. REFER TO PLAN 2 ON A2.51 FOR SCOPE OF WORK UNDER ALTERNATE BID.
  - PAINT FACE OF GYP. BD. SOFFIT P-6
  - PAINT FACE OF GYP. BD. SOFFIT P-7
  - PAINT FACE OF GYP. BD. SOFFIT P-6
  - PAINT FACE OF SOFFIT P-4
  - PAINT STRUCTURE ABOVE P-4 (NOT USED)
  - PROVIDE 6" METAL PERIMETER TRIM TRANSITION
  - BOUNDARY OF INDIVIDUAL SUSPENDED CEILING TILE GRIDS
  - SURFACE MOUNTED ROLLER SHADE
  - RECESSED ROLLER SHADE
  - DIFFUSERS & DEVICES SHOWN FOR REFERENCE - SUSPEND ABOVE WOOD GRILLE CEILING
  - DISH WASHER EXHAUST DUCT
  - FUTURE T.V./DIGITAL DISPLAY. BY USING AGENCY - N.I.C.
  - SECURITY GRILLE LOCATED ABOVE SAT CEILING SYSTEM
  - MOTORIZED PROJECTION SCREEN
  - REMOVE SCRIM AT DIFFUSER LOCATION. MOUNT DIFFUSERS FLUSH WITH BACK OF WOOD SLATS
  - PAINT DIFFUSERS IN FIELD (P-8)
  - HATCH INDICATES AREA OF NEW EIFS SOFFIT. DASHED LINE INDICATES CONTROL JOINT LOCATION
  - REINSTALL EXISTING LIGHT FIXTURES - SEE ELECTRICAL DRAWINGS.
  - REINSTALL EXISTING LIGHT FIXTURE - BY E.C.

**RCP SYMBOLS LEGEND:**

NOTE: REFER TO M.E.P.F. DRAWINGS FOR ADDITIONAL INFORMATION ON MECHANICAL, ELECTRICAL, AND FIRE PROTECTION SYSTEMS

	CEILING TYPE
	CEILING ELEVATION A.F.F.
	SUSPENDED ACOUSTICAL TILE CEILING
	GYP. BOARD CEILING OR SOFFIT
	LINEAR WOOD SLAT CEILING SYSTEM
	WOOD PANEL CEILING
	GREASE EXHAUST HOOD
	PSP MAKE UP DIFFUSER
	RADIANT HEAT PANEL, BY H.C.
	ROLLER SHADE (TYP.)
	RECESSED 2x4 FLUORESCENT LIGHT FIXTURE, BY E.C.
	RECESSED 2x2 FLUORESCENT LIGHT FIXTURE, BY E.C.
	RECESSED FLUORESCENT LIGHT LINEAR FIXTURE, BY E.C.
	RECESSED 4x4 FLUORESCENT LIGHT FIXTURE, BY E.C.
	SURFACE MOUNT 4x4 FLUORESCENT LIGHT FIXTURE, BY E.C.
	SMALL PENDANT LIGHT FIXTURE, BY E.C.
	RECESSED DOWN LIGHT, BY E.C.
	HEAT LAMP, BY E.C.
	RECESSED DOWN LIGHT, BY E.C.
	PENDANT LIGHT MOUNT FIXTURE, BY E.C.
	PENDANT LIGHT MOUNT LINEAR FIXTURE, BY E.C.
	PENDANT LIGHT MOUNT FIXTURE SMALL, BY E.C.
	PENDANT LIGHT MOUNT FIXTURE LARGE, BY E.C.
	SPRINKLER HEAD, BY SPC
	WALL LIGHT MOUNT FIXTURE, BY E.C.
	PENDANT LIGHT HUNG FLUORESCENT STRIP FIXTURE, BY E.C.
	RECESSED LIGHT LINEAR FLUORESCENT FIXTURE, BY E.C.
	WALL LIGHT MOUNT FLUORESCENT FIXTURE, BY E.C.
	TRACK MOUNT LIGHT FIXTURE, BY E.C.
	SCREEN - FURNISHED BY U.A. INSTALLED BY G.C. - N.I.C.
	CEILING MOUNTED PROJECTOR
	EXIT SIGN - SEE CODE COMPLIANCE PLAN, BY E.C.
	HEAT DETECTOR, BY E.C.
	SMOKE DETECTOR, BY E.C.
	EXISTING SMOKE DETECTOR, RELOCATED BY E.C.
	FIRE ALARM DEVICE, BY E.C.
	SPEAKER, N.I.C.
	CLOSED CIRCUIT CAMERA, VERIFY DIRECTION, BY E.C.
	CAMERA, N.I.C.
	OCCUPANT SENSOR, BY E.C.
	WIRELESS ACCESS POINT, BY E.C.
	VACANCY SENSOR, BY E.C.
	LIGHT SENSOR, BY E.C.
	CORD REEL, BY E.C.
	INDICATES EXISTING FIXTURE
	REMOVE AND RELOCATE EXISTING FIXTURE, BY E.C.
	RETURN AIR GRILLE, BY V.C.
	SUPPLY AIR GRILLE, BY V.C.
	LINEAR DIFFUSER - SUPPLY/RETURN, BY V.C.
	ACCESS PANEL
	CABINET UNIT HEATER OR FAN COIL UNIT, BY H.C.

NOTE: CONTRACTOR SHALL VERIFY ALL DIMENSIONS AND CONDITIONS AT JOB SITE AND BE FULLY RESPONSIBLE FOR SAME.

REVISIONS			DRAWN	PREPARED	OFF.
NO.	DESCRIPTION	DATE			
7	ISSUED FOR CONSTRUCTION	2015-07-31	TRACED	APPROVED	
10	RFP CD G-10, E-4	2016-04-15			
	RFP CD G-19	2016-05-05			

**DKA** DEMONICA KEMPER ARCHITECTS  
 125 N. HALSTED STREET, SUITE 301  
 CHICAGO, IL 60661  
 P: 312.496.0000

**KJWW** ENGINEERING  
 1100 WARRENVILLE ROAD, #400W NAPERVILLE, IL 60563  
 T: 630.527.2320

**E.F. WHITNEY, INC.**  
 568 ANN STREET BIRMINGHAM, MI 48009  
 T: 248.644.0990

**BOYD DEVELOPMENT**  
 Building a Better Illinois

State of Illinois  
 Pat Quinn, Governor  
 Illinois Capital Development Board

**ISSUED FOR CONSTRUCTION**  
**REFLECTED CEILING PLAN - LEVEL 6**

**CITY CENTER CAMPUS**  
**JOLIET JUNIOR COLLEGE**

PROJECT NO. CDB 810-048-023  
 DATE DEC. 12, 2014  
 SHEET NO. **A2.61** OF SHEETS