

B22002 Campus Police Renovation

Addendum #3



Addendum No. 3

Page 1 of 26

DATE: July 27, 2021

Joliet Junior College
1215 Houbolt Road
Joliet, IL 60431

TO: Prospective Bidders
SUBJECT: Addendum No. 3
PROJECT NAME: Campus Police Renovation
JJC PROJECT NO.: B22002

This Addendum forms a part of the Bidding and Contract Documents and modifies the original bidding document as posted on the JJC website. Acknowledge receipt of this addendum in the space provided on the Bid Form. FAILURE TO DO SO MAY SUBJECT BIDDER TO DISQUALIFICATION.

1. This addendum consists of both addenda items issued by the Architectural and Engineering (A/E) team and answers to questions asked by various bidders prior to the question cut-off date.
2. A final Addendum #4 will be issued prior to the end of the day on Thursday, July 29th.
3. ***The bid due date and time has been changed to Thursday, August 5, 2021 at 9:00 am.***

End of Addendum #3

Date: July 27, 2021

SECTION 00 90 03

**BIDDING AND CONTRACT REQUIREMENTS
ADDENDUM NUMBER 3**

Legat Architects, Inc.
2015 Spring Road, Suite #175
Oak Brook, IL 60523

Distributed via:
EMAIL

To: Prospective Bidders
Re: **ADDENDUM NUMBER 3 TO THE BIDDING DOCUMENTS FOR:**

Joliet Junior College
Campus Police Renovations
Architect's Project Number: 220120.00

This addendum forms a part of the bidding and contract documents and modifies the original bidding documents dated June 28, 2021. Acknowledge receipt of this addendum in the space provided on Bid Form. FAILURE TO DO SO MAY SUBJECT BIDDER TO DISQUALIFICATION.

I. PART 1 - ADDENDUM TO THE PROJECT MANUAL

- A. Document TOC - Table of Contents:
 - 1. Page TOC - 1, BIDDING AND CONTRACT REQUIREMENTS:
 - a. **ADD** Document Addendum Number 1 (Issued previously) to read as follows:
"Addendum Number 11"
 - b. **ADD** Document Addendum Number 2 (Issued previously) to read as follows:
"Addendum Number 221"
 - c. **ADD** Document 00 90 03 - Addendum Number 3 to read as follows:
"00 90 03 Addendum Number 3.....8"
 - 2. Page TOC - 2, DIVISION 8 - DOORS AND WINDOWS:
 - a. **ADD** Document 08 56 53 - Security Windows to read as follows:
"08 56 53 Security Windows.....4"
- B. Document Addendum Number 1 (Issued previously):
 - 1. **ADD** Document Addendum Number 1 in its entirety.
- C. Document Addendum Number 2 (Issued previously):
 - 1. **ADD** Document Addendum Number 2 in its entirety.
- D. Document 00 90 03 - Addendum Number 3:
 - 1. **ADD** Document 00 90 03 - Addendum Number 3 in its entirety.
- E. Document 01 10 00 - Summary:
 - 1. Page 01 10 00 - 4, Article 1.09 PROJECT PHASING:
 - a. **REVISE** Paragraph A. to read as follows:
"A. Phase 0"
 - b. **REVISE** Paragraph B. to read as follows:
"B. Phase 1"
 - c. **REVISE** Paragraph C. to read as follows:
"C. Phase 2"
 - 2. Page 01 10 00 - 5, Article 1.10 WORK BY OWNER, **ADD** Paragraph H. to read as follows:
"H. Tile Carpeting:

1. *Owner will furnish and contractor will install the following:*
 - a. *Field Carpet Tile - Type CPTT*
 - b. *Accent Carpet Tile - Type CPTT-A*
 - c. *Entry Walk-Off Carpet Tile - Type E-CPTT*
 2. *Contractor shall furnish all glues and adhesives*
 3. *Contractor shall furnish and install all rubber base surrounding carpet tile areas"*
- F. Document 08 56 53 - Security Windows:
1. **ADD** attached Document 08 56 53 - Security Windows in its entirety.
- G. Document 09 68 13 - Tile Carpeting:
1. Page 09 68 13 - 2, Article 2.02 MATERIALS, **ADD** Paragraphs D., E., and F. to read as follows::
 - "D. Owner will furnish and contractor will install the following:*
 1. *Field Carpet Tile - Type CPTT*
 2. *Accent Carpet Tile - Type CPTT-A*
 3. *Entry Walk-Off Carpet Tile - Type E-CPTT*
 - E. Contractor shall furnish all glues and adhesives*
 - F. Contractor shall furnish and install all rubber base surrounding carpet tile areas"*

II. PART 2 - ADDENDUM TO THE DRAWINGS

- A. Drawing CD101, titled, DEMOLITION PLAN:
1. **REPLACE** Drawings CD101 - DEMOLITION PLAN with attached Drawing CD101 - DEMOLITION PLAN (REVISION Addendum #3 - 07.27.21) in its entirety.
- B. Drawing ED101, titled, FIRST FLOOR ELECTRICAL DEMOLITION POWER PLAN:
1. **REPLACE** Drawings ED101 - FIRST FLOOR ELECTRICAL DEMOLITION POWER PLAN with attached Drawing ED101 - FIRST FLOOR ELECTRICAL DEMOLITION POWER PLAN (REVISION Addendum #3 - 07.27.21) in its entirety.
- C. Drawing E-100, titled, FIRST FLOOR ELECTRICAL POWER PLAN:
1. **REPLACE** Drawings E-100 - FIRST FLOOR ELECTRICAL POWER PLAN with attached Drawing E-100 - FIRST FLOOR ELECTRICAL POWER PLAN (REVISION Addendum #3 - 07.27.21) in its entirety.
- D. Drawing E-300, titled, FIRST FLOOR ELECTRICAL EQUIPMENT POWER PLAN:
1. **REPLACE** Drawings E-300 - FIRST FLOOR ELECTRICAL EQUIPMENT POWER PLAN with attached Drawing E-300- FIRST FLOOR ELECTRICAL EQUIPMENT POWER PLAN (REVISION Addendum #3 - 07.27.21) in its entirety.
- E. Drawing M-001, titled, MECHANICAL SCHEDULES:
1. **REPLACE** Drawings M-001 - MECHANICAL SCHEDULES with attached Drawing M-001 - MECHANICAL SCHEDULES (REVISION Addendum #3 - 07.27.21) in its entirety.
- F. Drawing MD101, titled, FIRST FLOOR MECHANICAL DEMOLITION PLAN:
1. **REPLACE** Drawings MD101 - FIRST FLOOR MECHANICAL DEMOLITION PLAN with attached Drawing MD101- FIRST FLOOR MECHANICAL DEMOLITION PLAN (REVISION Addendum #3 - 07.27.21) in its entirety.
- G. Drawing MD201, titled, FIRST FLOOR HYDRONIC & CONTROLS DEMOLITION PLAN:
1. **REPLACE** Drawings MD201- FIRST FLOOR HYDRONIC & CONTROLS DEMOLITION PLAN with attached Drawing MD201 - FIRST FLOOR HYDRONIC & CONTROLS DEMOLITION PLAN (REVISION Addendum #3 - 07.27.21) in its entirety.

- H. Drawing M-101, titled, FIRST FLOOR MECHANICAL PLAN:
1. **REPLACE** Drawings M-101 - FIRST FLOOR MECHANICAL PLAN with attached Drawing M-101 - FIRST FLOOR MECHANICAL PLAN (REVISION Addendum #3 - 07.27.21) in its entirety.
- I. Drawing M-201, titled, FIRST FLOOR HYDRONIC & CONTROLS PLAN:
1. **REPLACE** Drawings M-201 - FIRST FLOOR HYDRONIC & CONTROLS PLAN with attached Drawing M-201 - FIRST FLOOR HYDRONIC & CONTROLS PLAN (REVISION Addendum #3 - 07.27.21) in its entirety.
- J. Drawing M-301, titled, MECHANICAL ROOF PLAN:
1. **REPLACE** Drawings M-301 - MECHANICAL ROOF PLAN with attached Drawing M-301 - MECHANICAL ROOF PLAN (REVISION Addendum #3 - 07.27.21) in its entirety.
- K. Drawing M-302, titled, MECHANICAL ENLARGED PLAN AND LOW ROOF PLAN:
1. **REPLACE** Drawings M-302- MECHANICAL ENLARGED PLAN AND LOW ROOF PLAN with attached Drawing M-302- MECHANICAL ENLARGED PLAN AND LOW ROOF PLAN (REVISION Addendum #3 - 07.27.21) in its entirety.
- L. Drawing M-402, titled, MECHANICAL DETAILS:
1. **REPLACE** Drawings M-402 - MECHANICAL DETAILS with attached Drawing M-402 - MECHANICAL DETAILS (REVISION Addendum #3 - 07.27.21) in its entirety.
- M. Drawing ET101, titled, FIRST FLOOR ELECTRICAL TECHNOLOGY PLAN:
1. **REPLACE** Drawings ET101 - FIRST FLOOR ELECTRICAL TECHNOLOGY PLAN with attached Drawing ET101 - FIRST FLOOR ELECTRICAL TECHNOLOGY PLAN (REVISION Addendum #3 - 07.27.21) in its entirety.

III. PART 3 - CLARIFICATIONS

NOTE: The following questions were asked by various bidders prior to the question cut-off date and are not included elsewhere any addendum. Please find below each question (Q) with the corresponding answer (A).

- Q. We have located the bid documents online; is there any information available in terms of General Contractors bidding that we can reach out to possibly submit our pricing to?
A. *See Walk-thru Sign-in sheet posted to the website.*
- Q. Will premium time be required for the switch over of the dispatch office or can this be done during normal business hours?
A. *It can be performed during normal business hours.*
- Q. Is there any items to be salvaged other than the gym equipment?
A. *No, the Owner will removed any other items to be saved prior to construction as indicated in Section 01 10 00 - Summary.*
- Q. Who is responsible for removing, relocating or disposal of existing furniture, computers, monitors, TV's, Visual display boards, appliances?
A. *Owner will take care of this prior to start of construction.*
- Q. Does the first floor concrete slab have post tension cabling?
A. *Yes.*

- Q. Will background checks be required for the tradesmen, will the college pay for these directly or does the GC?
- A. *The Owner will not require it. The Contractor's own background and drug testing is sufficient.*
- Q. Will the awarded BP#2, BP#3, and BP#4 be known to the prior to the General Trades/Coordinating Contractor prior to the bid?
- A. *No, the bid opening is on the same day.*
- Q. The condensate drain piping is shown on the plumbing drawings. This piping is under the mechanical contractors scope of work.
- A. *The scope states to review ALL drawings as you will be responsible for any work that shows up on another trades drawings. This work shall fall under the mechanical trades as the Owner or A/E does not provide direction on the jurisdiction of the work in question. If the trades deem the work is plumbers work then it will be the responsibility for the mechanical trades to sub out to a plumber.*
- Q. Please clarify who is responsible for scanning the existing concrete floor slab. Plumbing scope section 2.1.24 states it is the Electrical/Fire Alarm's responsibility. Section 2.2.3 states the Plumber shall provide GPR to locate existing post tension cables.
- A. *Any trade that has underground slab work will be responsible for doing their own ground penetrating radar (GPR). Electrical and plumbing shall do their own if their work requires it.*
- Q. Can the underground demolition piping be cut and capped in place or does it need to be removed from the soil?
- A. *Cut and capped in place will be acceptable outside of the building footprint. Any piping inside of the building footprint must be fully removed. Any existing piping lefty in place must be clearly documented on the As-Built Drawings.*
- Q. Can the concrete be cut and removed with a machine and gas saw or is electric sawing required?
- A. *Due to ventilation concerns, electric saws shall be used.*
- Q. Will premium time be required for this project?
- A. *Contractor to review schedule posted for base bid and provide any necessary man power/premium time to meet the schedule.*
- Q. On P-201A and P201B please remove the gas piping from the drawing and place it under the mechanical contractors scope of work.
- A. *The scope states to review ALL drawings as you will be responsible for any work that shows up on another trades drawings. This work shall fall under the mechanical trades as the Owner or A/E does not provide direction on the jurisdiction of the work in question. If the trades deem the work is plumbers work then it will be the responsibility for the mechanical trades to sub out to a plumber.*
- Q. Will we be removing existing fixtures to be eliminated or will this be by an independant demolition company?
- A. *Each bid package is responsible for the demolition that falls under their trade.*
- Q. Are we to sawcut and remove the existing sanitary piping no longer in service or will it be divorced at the main underground and capped where it comes up to serve demoed fixtures and leave piping abandoned underground? The latter would eliminate expensive sawcutting and patching, either way we would like to price it up accordingly.
- A. *Cut and capped in place will be acceptable outside of the building footprint. Any piping inside of the building footprint must be fully removed. Any existing piping lefty in place must be clearly documented on the As-Built Drawings.*

- Q. Is there a drawing showing the extent of mudset to be removed and replaced at the locker room areas?
- A. *No, assume all areas under the existing ceramic floor tile in the shower/toilet areas include a mudset.*
- Q. How will we get material into the area of construction?
- A. *Doors at the entrance of Building 'G' may be used. Either door at the south stair towers on east and west side of Building 'G' may be used. Please note that there are stairs at these locations.*
- Q. Can I ask where I find the specific plans for the security features. I believe it mentioned access control and security cameras in the bid material.
- A. *Scope is clear. Door access and security camera systems are provided and installed by Owner. Contractor will be responsible for providing and installing data cable for cameras and yellow banana cable for door access.*
- Q. Is this a union job?
- A. *Documents contain the Project Labor Agreement for review, which must be signed by each awarded contractor. Contractors must be signatory.*
- Q. Please confirm what type of material is the existing underground piping.
- A. *All known pipe materials have been noted on the plans.*
- Q. The natural gas piping is shown on the plumbing plans. Can we assume that this means the natural gas piping is by the plumbing bid package? It is not clear in the scopes of work for the Plumbing or Mechanical bid package.
- A. *The scope states to review ALL drawings as you will be responsible for any work that shows up on another trades drawings. This work shall fall under the mechanical trades as the Owner or A/E does not provide direction on the jurisdiction of the work in question. If the trades deem the work is plumbers work then it will be the responsibility for the mechanical trades to sub out to a plumber.*
- Q. The condensate drain piping is also shown on the plumbing plans. Can we assume this means the condensate drain piping is also by the plumbing bid package? Can we assume that this means the natural gas piping is by the plumbing bid package? It is not clear in the scopes of work for the plumber or HVC bid package
- A. *The scope states to review ALL drawings as you will be responsible for any work that shows up on another trades drawings. This work shall fall under the mechanical trades as the Owner or A/E does not provide direction on the jurisdiction of the work in question. If the trades deem the work is plumbers work then it will be the responsibility for the mechanical trades to sub out to a plumber.*
- Q. Can we connect the temporary heat to existing campus utilities?
- A. *Yes.*
- Q. On page 3 of the Instructions to Bidders, the business enterprise program (BEP) is listed. Is this a requirement for this project? If this is a requirement please issue a breakdown of percentages for each contract or state that it is combined.
- A. *The business enterprise program forms are required for bidders utilizing subcontractors and for BEP certified firms that are self-performing. The Owner's goal for each bid package is 20%.*
- Q. During the walk-throughs, I was informed the Owner is supplying the security cameras? Is a security company required for this project?
- A. *Refer to scope of work. Electrical contractor responsible for providing and installing data cable for cameras and banana cable for door access. Owner provides and installs the cameras and door access system.*

- Q. Please confirm if MEP bid packages will be due before the GC packages which is typical when these trades are broken out from the general trades.
- A. *No, the bid opening is on the same day.*
- Q. Please confirm if low voltage trades such as audio visual (A/V), security, or tele data are to be carried under the Electrical/Fire Alarm Trade's package or under the General Trade's package
- A. *It is under the Electrical/Fire Alarm bid package.*
- Q. BP#1, 2.3 states that General Trades is to supply dumpsters for trench excavation. I am assuming this is for concrete slab removal?
- A. *Correct.*
- Q. Please clarify who layouts saw-cut lines for plumbing trenches?
- A. *Plumbing Trades with General Trade's coordination.*
- Q. Please clarify who saw-cuts existing slab for plumbing trenches?
- A. *Plumbing Trades with General Trade's coordination.*
- Q. Please clarify who removes existing concrete slabs and properly disposes of slabs? (Typically, the saw-cutting contractor will also remove and dispose of the slabs.)
- A. *The contractor that is saw cutting the slabs also removes the slabs to the General Trade's provided dumpster.*
- Q. Please confirm that there is no fire protection work in Base Bid? Only in Alt #1 and Alt #2?
- A. *Yes, there is only fire protection work under Alternate Bids #1 and #2. There is no fire protection work in base bid (only fire alarm).*
- Q. The existing building is not sprinkled?
- A. *Correct, the existing building is not sprinkled.*
- Q. On sheet CD101 it indicates existing water spigots to be removed and pipe capped. What bid package is responsible for these items?
- A. *Plumbing Trades Contractor.*
- Q. On sheet CD101 it indicates for the existing hot water heat vault to be removed. What bid package is responsible for this item?
- A. *The piping in this vault is abandoned. The General Trades Contractor is responsible for cutting abandoned pipe and removing concrete vault. Back filling and restoration of area is also by General Trades Contractor.*
- Q. The documents say that BP#1 is responsible to supply dumpsters for demolition for all bid packages. However, does this apply for large pieces of equipment? For example, (6) rooftop units are being demolished by BP#2. These rooftop units are expected to go into dumpsters? Large pieces of equipment should be hauled and disposed of off-site by whoever is demolishing them. Please clarify.
- A. *Large pieces of equipment such as the roof top units, air handler on first floor, etc. are to be removed and disposed by the mechanical contractor.*
- Q. Regarding the steel platform that is by BP#1 per Addendum #2, who is responsible for cutting existing roofing at the (4) columns?
- A. *Mechanical Trades Contractor is responsible to cut the roof.*

- Q. Who is responsible for roof patching at the (4) columns? As to avoid multiple roofing contractors, it would make sense that BP#2 be responsible for this, as they will most likely have a roofer onsite patching their other roof penetrations?
- A. *Mechanical Trades Contractor is responsible to patch the roof.*
- Q. BP#1, 8.15 states that BP#1 shall provide all perimeter drain tile if called for in the contract documents. Wouldn't this fall under BP#4 plumbing work
- A. *Drain tile is not a requirement of the Contract Documents.*
- Q. Are there additional insurance requirements?
- A. *No additional insurance requirements exist except from those listed on pages 4-6 in document B22002 Campus Police Renovation.pdf.*
- Q. What exclusions are being referenced?
- A. *No additional insurance requirements from those listed on pages 4-6 in document B22002 Campus Police Renovation.pdf.*
- Q. We have reviewed the attached Instructions to Bidders. We just wanted to let you know that according to the attached instructions, there could be different insurance requirements contained in a "Schedule A" and/or possibly an attachment to this agreement entitled "Insurance Specifications" that is referenced but that you may not have been provided. We recommend checking back with Joliet Jr. College to make sure there aren't any separate specifications in addition to the Instructions to Bidders that would need to be reviewed.
- A. *No additional insurance requirements from those listed on pages 4-6 in document B22002 Campus Police Renovation.pdf.*
- Q. Please confirm if the MEP Trade Packages will be due before the GC bid package. Typically this is the case so the GC can determine the proper fee to charge for coordination of these trades even though they are to be contracted by Owner.
- A. *All bid packages are due at the same day and at the same time. MEP packages will not be opened prior to General Trades Package.*
- Q. There is a note on sheet CD101 stating: "Existing "Hot Water Heat Vault" previously removed from service. Contractor shall internal pipes and remove vault (full depth). This note is confusing, please clarify.
- A. *Existing concrete vault is to be removed by the General Trades Contractor. Existing vault contains abandoned 12" pipe that can be cut and capped (by General Trades). General Trades to backfill and restore area around vault.*
- Q. Which package is responsible for the exterior utility relocation work?
- A. *Any underground electrical site utility is the responsibility of the Electrical/Fire Alarm Trades Contractor. Any water, sanitary or storm underground utilities is the responsibility of the General Trades/Coordinating Contractor. Any underground gas utility shall be the responsibility of the Plumbing Trades Contractor.*
- Q. During the site visit we saw many areas that had furniture, lockers, wall hung shelving, mail boxes, etc. that are not indicated on the drawings to be removed/salvaged. If not indicated to be removed, are we to assume that these will be removed by others.
- A. *Furniture, loose, unattached lockers, etc. will be removed by Owner prior to start of construction as indicated in Section 01 10 00 - Summary.*

END OF SECTION

This addendum consists of eight (8) pages.

This addendum has four (4) standard pages and thirteen (13) large drawing sheets attached as identified below:

Specification Sections:

08 56 53 - Security Windows (4 Pages)

Drawings:

CD101 - DEMOLITION PLAN (REVISION Addendum #3 – 07.27.21) (1 Full Sheet)
ED-100 - FIRST FLOOR ELECTRICAL DEMOLITION POWER PLAN (REVISION Addendum #3 - 07.27.27) (1 Full Sheet)
E-100 - FIRST FLOOR ELECTRICAL POWER PLAN (REVISION Addendum #3 - 07.27.21) (1 Full Sheet)
E-300 - FIRST FLOOR ELECTRICAL EQUIPMENT POWER PLAN (REVISION Addendum #3 - 07.27.21) (1 Full Sheet)
M-001 - MECHANICAL SCHEDULES (REVISION Addendum #3 - 07.27.21) (1 Full Sheet)
MD101 - FIRST FLOOR MECHANICAL DEMOLITION PLAN (REVISION Addendum #3 - 07.27.21) (1 Full Sheet)
MD201 - FIRST FLOOR HYDRONIC & CONTROLS DEMOLITION PLAN (REVISION Addendum #3 - 07.27.21) (1 Full Sheet)
M-101 - FIRST FLOOR MECHANICAL PLAN (REVISION Addendum #3 - 07.27.21) (1 Full Sheet)
M-201 - FIRST FLOOR HYDRONIC & CONTROLS PLAN (REVISION Addendum #3 - 07.27.21) (1 Full Sheet)
M-301 - MECHANICAL ROOF PLAN (REVISION Addendum #3 - 07.27.21) (1 Full Sheet)
M-302 - MECHANICAL ENLARGED PLAN AND LOW ROOF PLAN (REVISION Addendum #3 - 07.27.21) (1 Full Sheet)
M-402 - MECHANICAL DETAILS (REVISION Addendum #3 - 07.27.21) (1 Full Sheet)
ET101 - FIRST FLOOR ELECTRICAL TECHNOLOGY PLAN (REVISION Addendum #3 - 07.27.21) (1 Full Sheet)

SECTION 08 56 53
SECURITY WINDOWS

PART 1 GENERAL

1.01 SECTION INCLUDES

- A. Security view windows, with glazing.
- B. Security transaction windows with pass-through device.

1.02 RELATED REQUIREMENTS

- A. Section 04 20 02 - Single-Wythe Unit Masonry.
- B. Section 07 90 05 - Joint Sealers: Sealing joints between frames and adjacent construction.
- C. Section 12 24 00 - Window Shades.

1.03 REFERENCE STANDARDS

- A. AAMA 611 - Voluntary Specification for Anodized Architectural Aluminum; 2014 (2015 Errata).
- B. ASTM A27/A27M - Standard Specification for Steel Castings, Carbon, for General Application; 2020.
- C. ASTM A36/A36M - Standard Specification for Carbon Structural Steel; 2014.
- D. ASTM A47/A47M - Standard Specification for Ferritic Malleable Iron Castings; 1999, with Editorial Revision (2018).
- E. ASTM A627 - Standard Test Methods for Tool-Resisting Steel Bars, Flats, and Shapes for Detention and Correctional Facilities; 2003 (Reapproved 2011).
- F. ASTM A653/A653M - Standard Specification for Steel Sheet, Zinc-Coated (Galvanized) or Zinc-Iron Alloy-Coated (Galvannealed) by the Hot-Dip Process; 2020.
- G. ASTM A666 - Standard Specification for Annealed or Cold-Worked Austenitic Stainless Steel Sheet, Strip, Plate, and Flat Bar; 2015.
- H. ASTM A1008/A1008M - Standard Specification for Steel, Sheet, Cold-Rolled, Carbon, Structural, High-Strength Low-Alloy, High-Strength Low-Alloy with Improved Formability, Solution Hardened, and Bake Hardenable; 2018.
- I. ASTM B221 - Standard Specification for Aluminum and Aluminum-Alloy Extruded Bars, Rods, Wire, Profiles, and Tubes; 2014.
- J. ASTM B221M - Standard Specification for Aluminum and Aluminum-Alloy Extruded Bars, Rods, Wire, Profiles, and Tubes (Metric); 2013.
- K. ASTM E90 - Standard Test Method for Laboratory Measurement of Airborne Sound Transmission Loss of Building Partitions and Elements; 2009 (Reapproved 2016).
- L. ASTM E413 - Classification for Rating Sound Insulation; 2016.
- M. ASTM E488/E488M - Standard Test Methods for Strength of Anchors in Concrete Elements; 2018.
- N. ASTM F588 - Standard Test Methods for Measuring the Forced Entry Resistance of Window Assemblies, Excluding Glazing Impact; 2017.
- O. ASTM F1233 - Standard Test Method for Security Glazing Materials And Systems; 2008 (Reapproved 2013).
- P. ASTM F1915 - Standard Test Methods for Glazing for Detention Facilities; 2005 (Reapproved 2012).
- Q. HPW-TP-0500.03 - Test Procedure-Transparent Materials for Use in Forced Entry or Containment Barriers; 2003.
- R. NFRC 100 - Procedure for Determining Fenestration Product U-factors; 2017.
- S. NIJ 0108.01 - Standard for Ballistic Resistant Protective Materials; 1985.
- T. UL (DIR) - Online Certifications Directory; Current Edition.

- U. UL 752 - Standard for Bullet-Resisting Equipment; Current Edition, Including All Revisions.

1.04 ADMINISTRATIVE REQUIREMENTS

- A. Coordination: Furnish anchorages, including sleeves, concrete inserts, anchor bolts, and items with integral anchors, to be embedded into concrete or masonry, with setting diagrams and installation, to applicable installer in time for installation.
- B. Preinstallation Meeting: Prior to start of installation arrange a meeting on site to familiarize installer and installers of related work with requirements relating to this work.

1.05 SUBMITTALS

- A. See Section 01 30 00 - Administrative Requirements, for submittal procedures.
- B. Product Data: Manufacturer's published data showing materials, construction details, dimensions of components, and finishes.
- C. Shop Drawings: Drawings prepared specifically for this project, showing plans, elevations, sections, details of construction, anchorage to other work, hardware, and glazing.
 - 1. For new work show required opening dimensions and allowance for field deviation.
- D. Test Reports: Test reports for specific window model and glazing to be furnished, showing compliance with specified requirements; window and glazing may be tested separately, provided window test sample adequately simulates the glazing to be used.
 - 1. Include testing agency qualifications.
 - 2. For structural, forced entry, and ballistic tests, provide details on method of anchorage to test frame.
- E. Samples of Color Anodized Finishes: Frame member sections showing range of color to be expected in finished work.
- F. Coordination Drawings: For each window opening, show locations and details of items necessary to anchor windows that must be installed by others, in sufficient detail that installer of those items can do so correctly without reference to the actual window itself.

1.06 QUALITY ASSURANCE

- A. Manufacturer Qualifications: Firm with at least 5 years experience in the manufacture of windows of the type specified and able to provide test reports showing that their standard manufactured products meet the specified requirements; custom designed products not acceptable.
- B. Installer Qualifications: Company specializing in performing work of the type specified and with at least five years of documented experience.

1.07 WARRANTY

- A. See Section 01 78 00 - Closeout Submittals, for additional warranty requirements.
- B. Provide manufacturer's warranty agreeing to repair or replace windows and window components that fail within three years after Date of Substantial Completion due to, but not limited to, the following:
 - 1. Structural failure, failure of welds, and deterioration of metals and finishes beyond that expected under detention use and normal weathering.
 - 2. Failure of glazing due to excessive deflection of supporting members under wind load.

PART 2 PRODUCTS

2.01 MANUFACTURERS

- A. Security Windows:
 - 1. Basis of Design Manufacturer:
 - a. Insulgard Security Products; 44/450 Architectural Aluminum Framing System: www.insulgard.com.
 - 2. Other Acceptable Manufacturers:
 - a. Chicago Bullet Proof Systems: www.chicagobulletproof.com.
 - b. Krieger Specialty Products: www.kriegerproducts.com.

- c. National Bullet Proof, Inc: www.nationalbulletproof.com.
 - d. Overly Door Company: www.overly.com.
 - e. Substitutions: See Section 01 60 00 - Product Requirements.
- B. Security Glazing:
 - 1. Basis of Design Manufacturer:
 - a. Lexgard; 1-1/4 inch SP1250: www.insulgard.com.
 - 2. Other Acceptable Manufacturers:
 - a. Sierracin Corporation: www.sierracin.com.
 - b. North America Specialty Glass: www.naspecialtyglass.com.
 - c. Viracon, Apogee Enterprises, Inc: www.viracon.com.
 - d. Substitutions: See Section 01 60 00 - Product Requirements.
 - 3. Ballistic Resistant:
 - a. Level 3 in accordance with UL 752 - Testing for Ballistic Resistance for the complete assembly including framing, glazing and panels.
- C. Security Fasteners:
 - 1. Acument Global Technologies: www.acument.com/#sle.
 - 2. Safety Socket Screw Corporation: www.safetysocket.com/#sle.
 - 3. Tamperproof Screw Co, Inc: www.tamperproof.com/#sle.
 - 4. Tamper-Pruf Screws, Inc: www.tamper-pruf-screws.com/#sle.
 - 5. Substitutions: See Section 01 60 00 - Product Requirements.

2.02 ASSEMBLIES

- A. Security Windows:
 - 1. Dimensions, profiles, features, and performance specified and indicated on drawings are required; do not deviate unless specifically approved by Architect under substitution procedures specified in Section 01 60 00.
 - 2. Design to fit openings indicated on drawings; design to accommodate deviation of actual construction from dimensions indicated on drawings.
 - 3. Fabricate frames and sash with corners mitered or coped full depth with concealed welded joints.
 - 4. Design anchorages to provide performance equivalent to that required for window unit; provide anchorages at least equivalent to those by which the tested units were anchored to the test frame.
 - 5. Separate dissimilar metals to prevent corrosion by galvanic action by painting contact surfaces with primer or with sealant or tape recommended by manufacturer for the purpose.
 - 6. Weld components before finishing and in concealed locations, to greatest extent possible; minimize distortion and discoloration of finish; remove residue of welding; grind exposed welds smooth and finish to match.
 - 7. Label units to indicate which side is which, such as inside/outside or secure/non-secure; use labels that are removable after installation but durable enough not to be lost during delivery, storage, handling, and installation.

2.03 SECURITY WINDOWS

- A. Security Windows: Factory-assembled fixed glazing panel reglazable from secure side without disassembly of frame, with non-removable trim and glazing stops on non-secure side (outside).
- B. Glazing Material:
 - 1. Framing and Glazing Stops: Formed aluminum-clad steel sheet; color anodized finish.
 - 2. Ballistic Resistance: UL 752 Level 3 (super-power handgun).
 - 3. Forced Entry Resistance: ASTM F1915 Grade I, tested from outside.

2.04 ASSEMBLY COMPONENTS

- A. Aluminum Framing: ASTM B221 (ASTM B221M) extrusions of alloy and temper selected by manufacturer for strength, corrosion resistance, and finish required; not less than 1/8 inch thick at any location of frame and sash members.

- B. Frame Anchors: Mild steel plates, shapes, or bars, concealed in completed construction; provide anchorage devices as necessary to securely fasten windows to adjacent construction; use security fasteners for exposed anchors.
 - 1. Provide minimum of two anchors per side of window plus one additional anchor for each 18 inches or fraction thereof more than 36 inches in height or width.
- C. Glazing Seals: Factory installed; molded EPDM or neoprene compressible gaskets and compression strips.
- D. Writing Shelf: 4" deep solid surface sill as provided by countertop contractor.
- E. Speaking Aperture Covers: Stainless steel, round, allowing passage of speech at normal volume without distortion; listed and labeled by UL (DIR) as bullet resisting to UL 752, Level 3.
- F. Bituminous Paint: Cold-applied asbestos-free asphalt mastic, complying with SSPC-Paint 33; 30 mils, 0.030 inch minimum thickness per coat.

2.05 FINISHES

- A. Class I Natural Anodized Finish: AAMA 611 AA-M12C22A41 Clear anodic coating not less than 0.7 mils thick.

PART 3 EXECUTION

3.01 EXAMINATION

- A. Verify that window openings are ready for installation of windows.
- B. Verify that correct embedded anchors are in place and in proper location; repair or replace anchors as required to achieve satisfactory installation.
- C. Notify Architect if conditions are not suitable for installation of windows; do not proceed until conditions are satisfactory.

3.02 INSTALLATION

- A. Install in accordance with manufacturer's instructions and drawing details.
- B. Install windows in correct orientation (inside/outside or secure/non-secure).
- C. Anchor windows securely in manner so as to achieve performance specified.
- D. Separate metal members from concrete and masonry using bituminous paint.
- E. Set sill members and sill flashing in continuous bead of sealant.

3.03 ADJUSTING

- A. Adjust operating components for smooth operation while also providing tight fit at contact points and a secure enclosure; lubricate operating hardware.



3.04 CLEANING

- A. Clean exposed surfaces promptly after installation without damaging finishes.
- B. Remove and replace defective work.

3.05 CLOSEOUT ACTIVITIES

- A. Demonstrate operation and maintenance to designated Owner personnel.

END OF SECTION

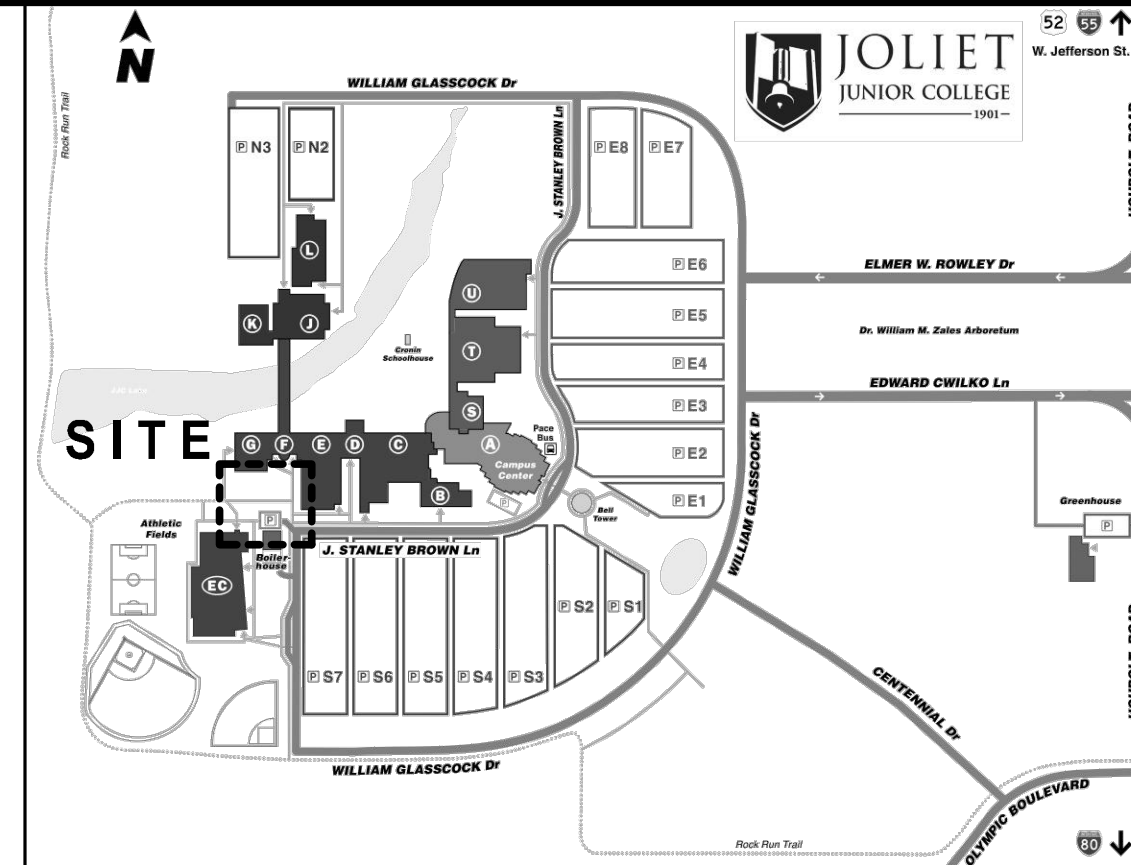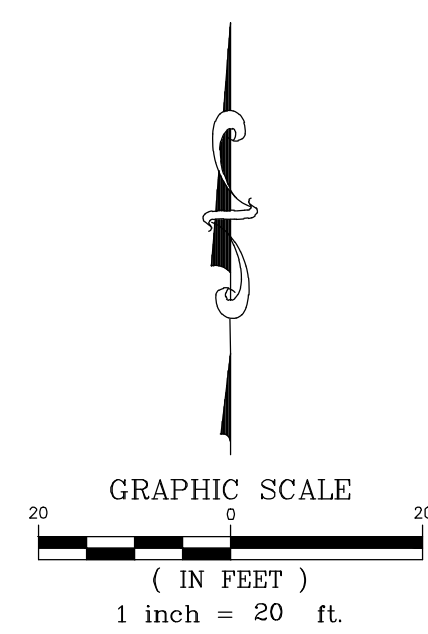

LEGATARCHITECTS
DESIGN | PERFORMANCE | SUSTAINABILITY

**JOLIET
JUNIOR
COLLEGE**

**CAMPUS POLICE
RENOVATIONS**

1215 Houbolt Road
Joliet, IL 60431

ARCHITECT
Legat Architects

2015 Spring Road, Suite 175
Oak Brook, IL, 60523
P: 630.990.3541
www.legat.com

CIVIL ENGINEER
RT&A Inc.


129 Capista Drive
Shorewood, IL 60404
P: 815.744.6600
www.ruettigertonnelli.com

STRUCTURAL ENGINEER
Pease Borst & Associates

18 Executive Court
South Barrington, IL 60010
P: 847.842.6930
F: 847.842.6935
www.peaseborst.com

MER/FP ENGINEER
**RTM Engineering
Consultants**

650 E. Algonquin, Suite 250
Schaumburg, IL 60173
P: 847.756.4180
www.rtmec.com

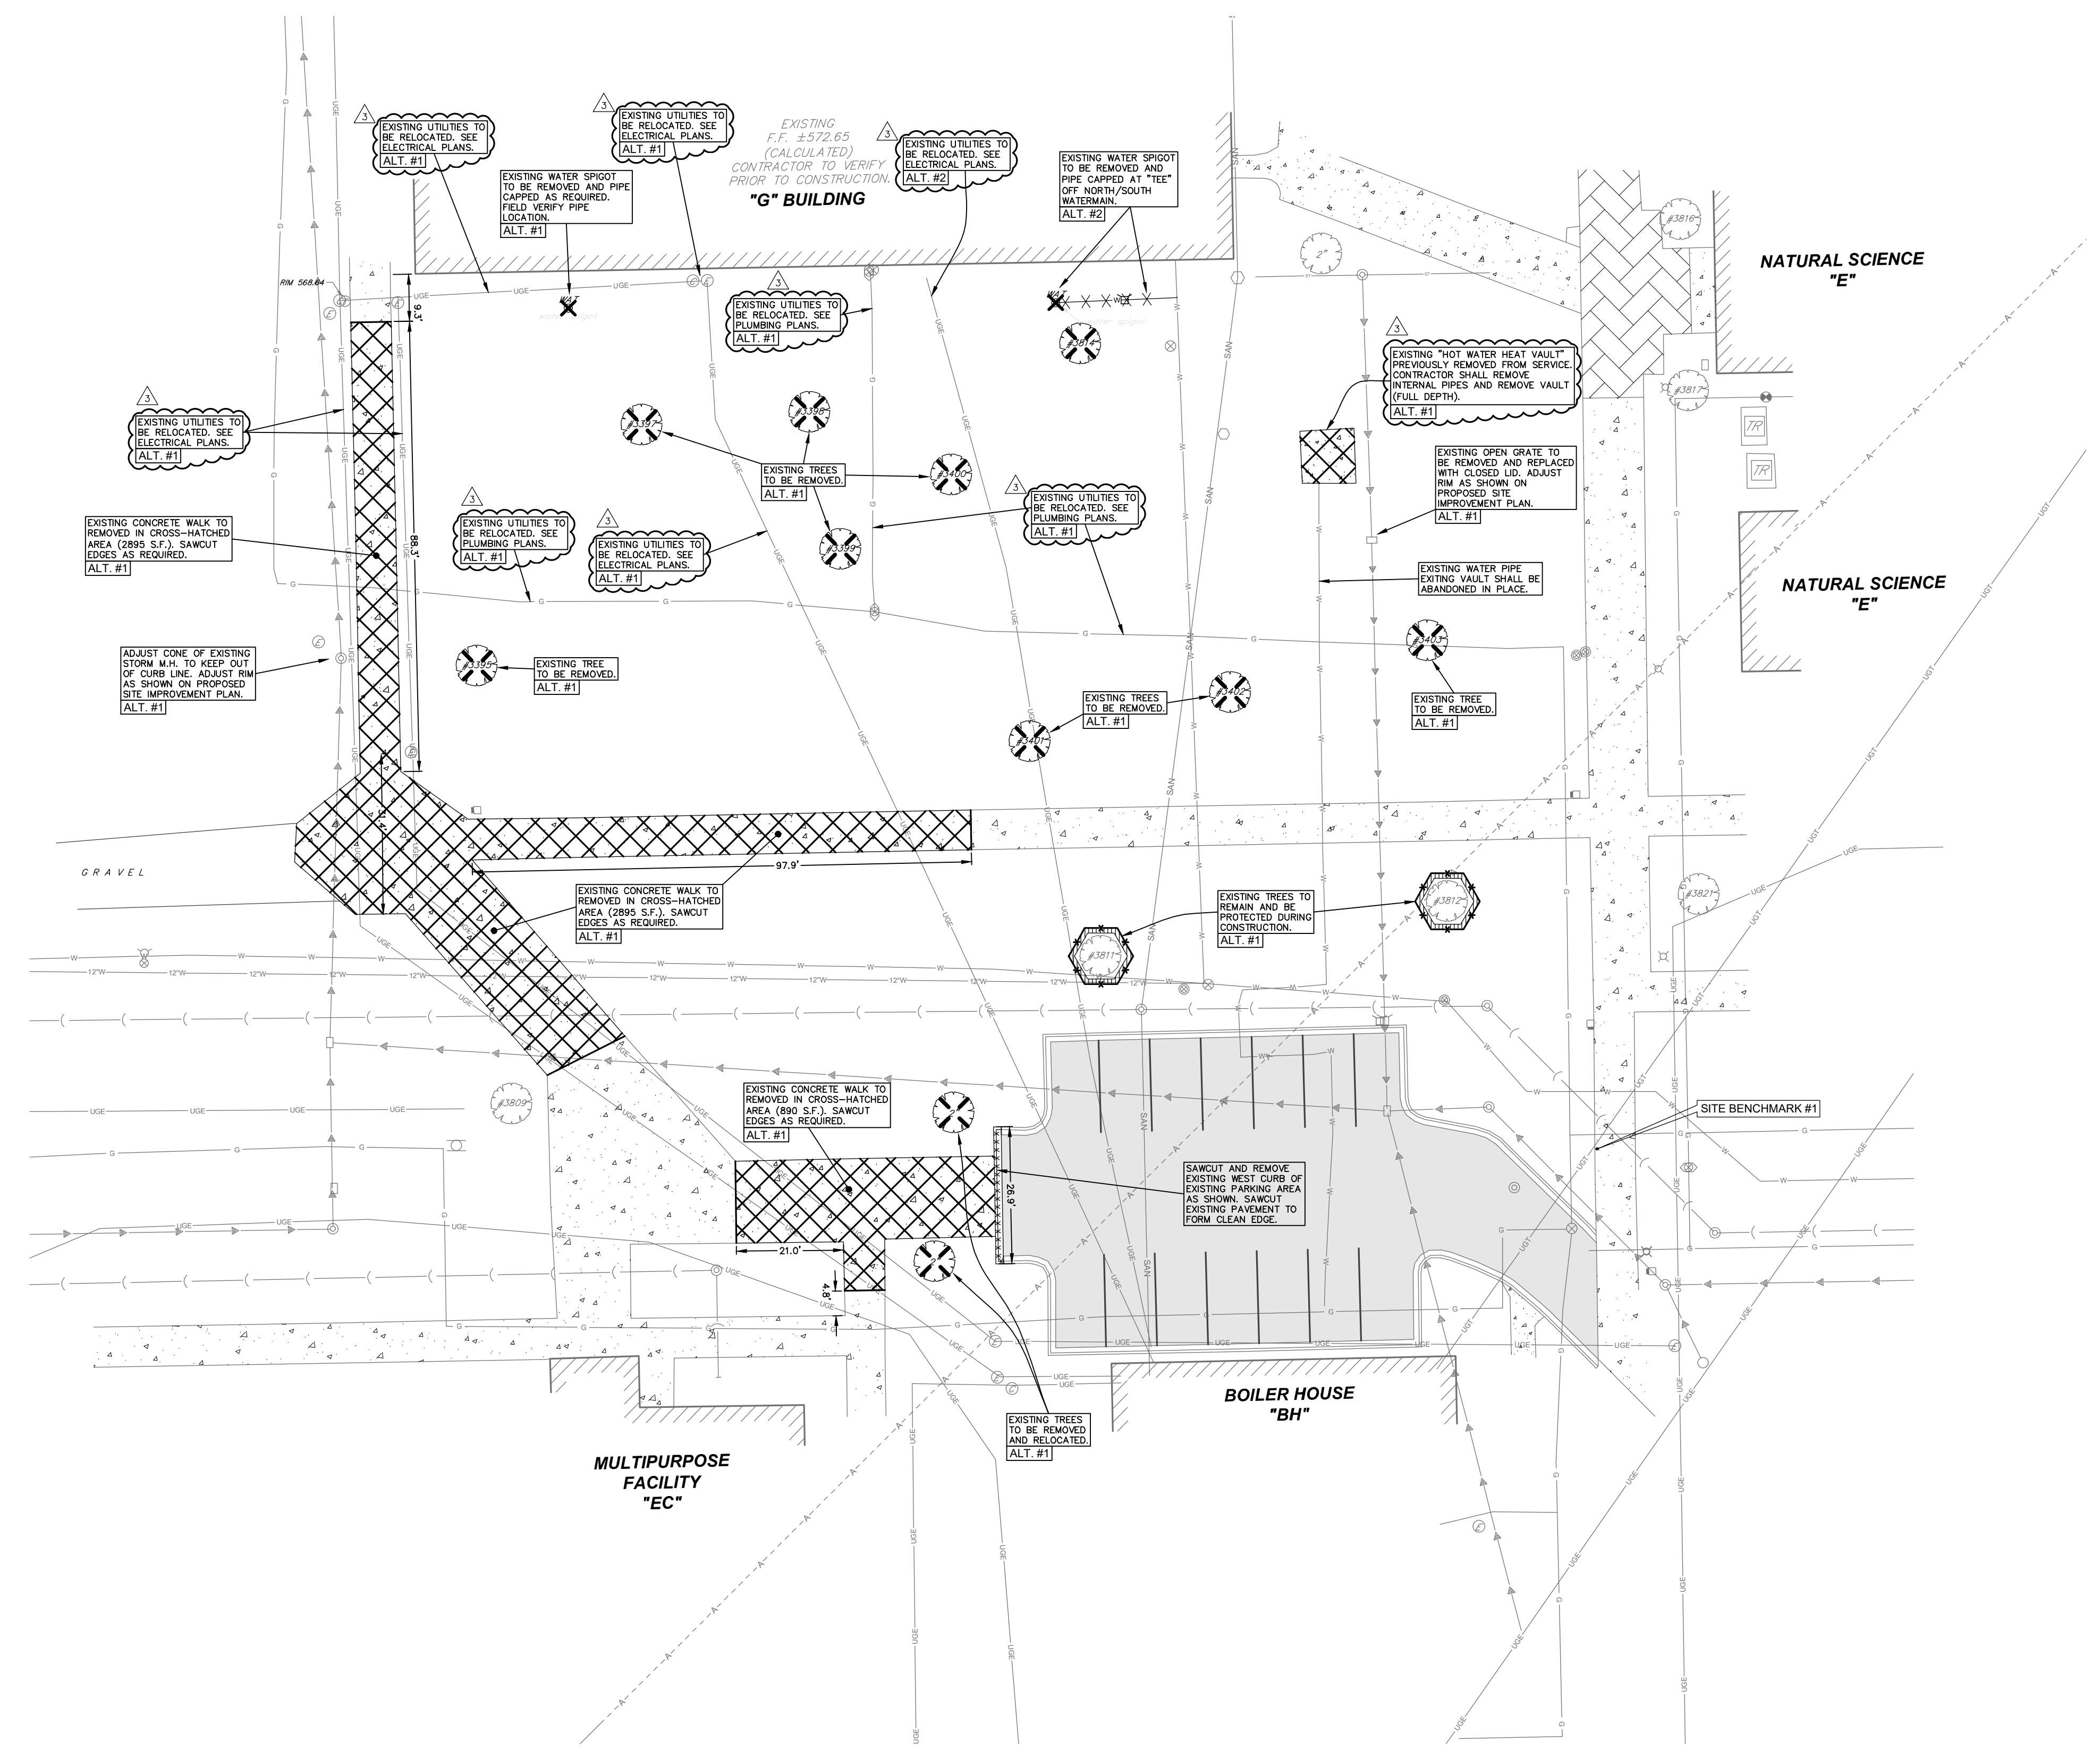

LEGEND	
XXX.XX	EXISTING ELEVATION
T/F	TOP OF FOUNDATION
F.F.	FINISHED FLOOR
CMP	CORRUGATED METAL PIPE
FES	FLARED END SECTION
T/WALL	TOP OF WALL
FL	FLOW LINE
RCP	REINFORCED CONCRETE PIPE
CPP	CORRUGATED PLASTIC PIPE
PVC	POLYVINYL CHLORIDE PIPE
U	UTILITY POLE
GA	GUY ANCHOR
UE	UNDERGROUND ELECTRIC LINES
OE	OVERHEAD ELECTRIC LINES
SL	STREET LIGHT
V	VALVE & VAULT
FH	FIRE HYDRANT
SI	STORM SEWER INLET
SM	STORM SEWER MANHOLE
SS	STORM SEWER LINES
ST	"SUSPECTED" STORM SEWER LINES
CH	CABLE TV HANDHOLE
CD	CABLE TV PEDESTAL
CTV	UNDERGROUND CABLE TV LINES
TP	TELEPHONE PEDESTAL
TCM	TELEPHONE CONTROL MANHOLE
UL	UNDERGROUND TELEPHONE LINES
S	SIGN
UGL	UNDERGROUND GAS LINES
SCB	SIGNAL CONTROL BOX
SP	SIGNAL PEDESTAL
SLC	EXISTING SOIL BORING LOCATION
ET	EVERGREEN TREE W/ DIAMETER
BT	BUSH W/ DIAMETER
TS	TRAFFIC SIGNAL
SH	TRAFFIC SIGNAL HANDHOLE
GM	GAS METER
SMH	SANITARY SEWER MANHOLE
SSM	"SUSPECTED" SANITARY SEWER LINES
GR	GUARDRAIL
EB	ELECTRIC BOX
EH	ELECTRIC HANDHOLE
EO	ELECTRIC OUTLET
ET	ELECTRIC TRANSFORMER
GV	GAS VALVE BOX
LB	LANDSCAPE LIGHT
BB	BURFALL BOX
HWP	HAND WATER PUMP
EM	ELECTRIC METER
USWL	"SUSPECTED" UNDERGROUND WATER LINES
RP	ROPE POST
ICV	IRRIGATION CONTROL VALVE
CO	CLEAN OUT
TH	TELEPHONE HANDHOLE
LH	LIGHT HANDHOLE
TR	TREE REMOVAL
IR	EXISTING ITEM TO BE REMOVED AS NOTED
IBP	EXISTING BITUMINOUS PAVEMENT TO BE GRIND 2" DEEP
ICR	EXISTING CURB TO BE REMOVED AS NOTED
IR	EXISTING ITEM TO BE REMOVED AS NOTED

DEMOLITION PLAN NOTES

1.) CONTRACTOR TO VERIFY ALL QUANTITIES NOTED ON PLANS AND INCLUDE AS PART OF BID.

2.) SAWCUT ALL PAVEMENT, CURB AND SIDEWALK JOINTS.

3.) FIELD VERIFY LOCATION OF EXISTING UTILITIES. PROVIDE ADEQUATE PROTECTION OF UTILITIES TO REMAIN IN USE AND COORDINATE WORK IN THESE AREAS WITH THE CONSTRUCTION MANAGER AND JOLIET JUNIOR COLLEGE PERSONNEL. ALL WORK SHALL BE DONE IN ACCORDANCE WITH ALL APPLICABLE LOCAL REGULATIONS.

SITE BENCHMARK #1:
CUT CROSS IN CONCRETE WALK APPROXIMATELY 28' EAST AND 40' NORTH OF NORTHEAST CORNER OF BOILER HOUSE "BH" (N: 1760384.465, E: 1025628.614) ELEVATION = 569.07

RT & A **Ruettiger, Tonelli & Associates, Inc.**
Surveyors • Engineers • Planners • Landscape Architects • G.I.S. Consultants
129 CAPISTA DRIVE • SHOREWOOD, ILLINOIS 60404
PH (815) 744-6600 FAX (815) 744-0101
WWW.RUETTIGERTONELLI.COM
LATEST R.T. & A. REVISION: 07-27-2021
FIELD BOOK & PAGE: JUC Bk 1, P 53
R.T. & A. Dwg. No.: 420-0314-C1


SIGNATURE _____		
DATE _____		
REVISIONS		
NO.	DESCRIPTION	DATE
1	ADDENDUM #3	07.27.21

PROJECT NUMBER 220120.00
DATE OF ISSUE 07.27.21
DRAWN BY R.P. & RT&A
CHECKED BY J.H. & RT&A

DEMOLITION PLAN

CD101
ISSUED FOR BIDDING

Call Before You Dig
JULIE
ILLINOIS
ONE-CALL SYSTEM
CONTACT JULIE AT 811 OR 800-882-0123
48 Hours (7) Working Days BEFORE YOU DIG.
Include the following:
County, City/Township, Section & 1/4 Section No.

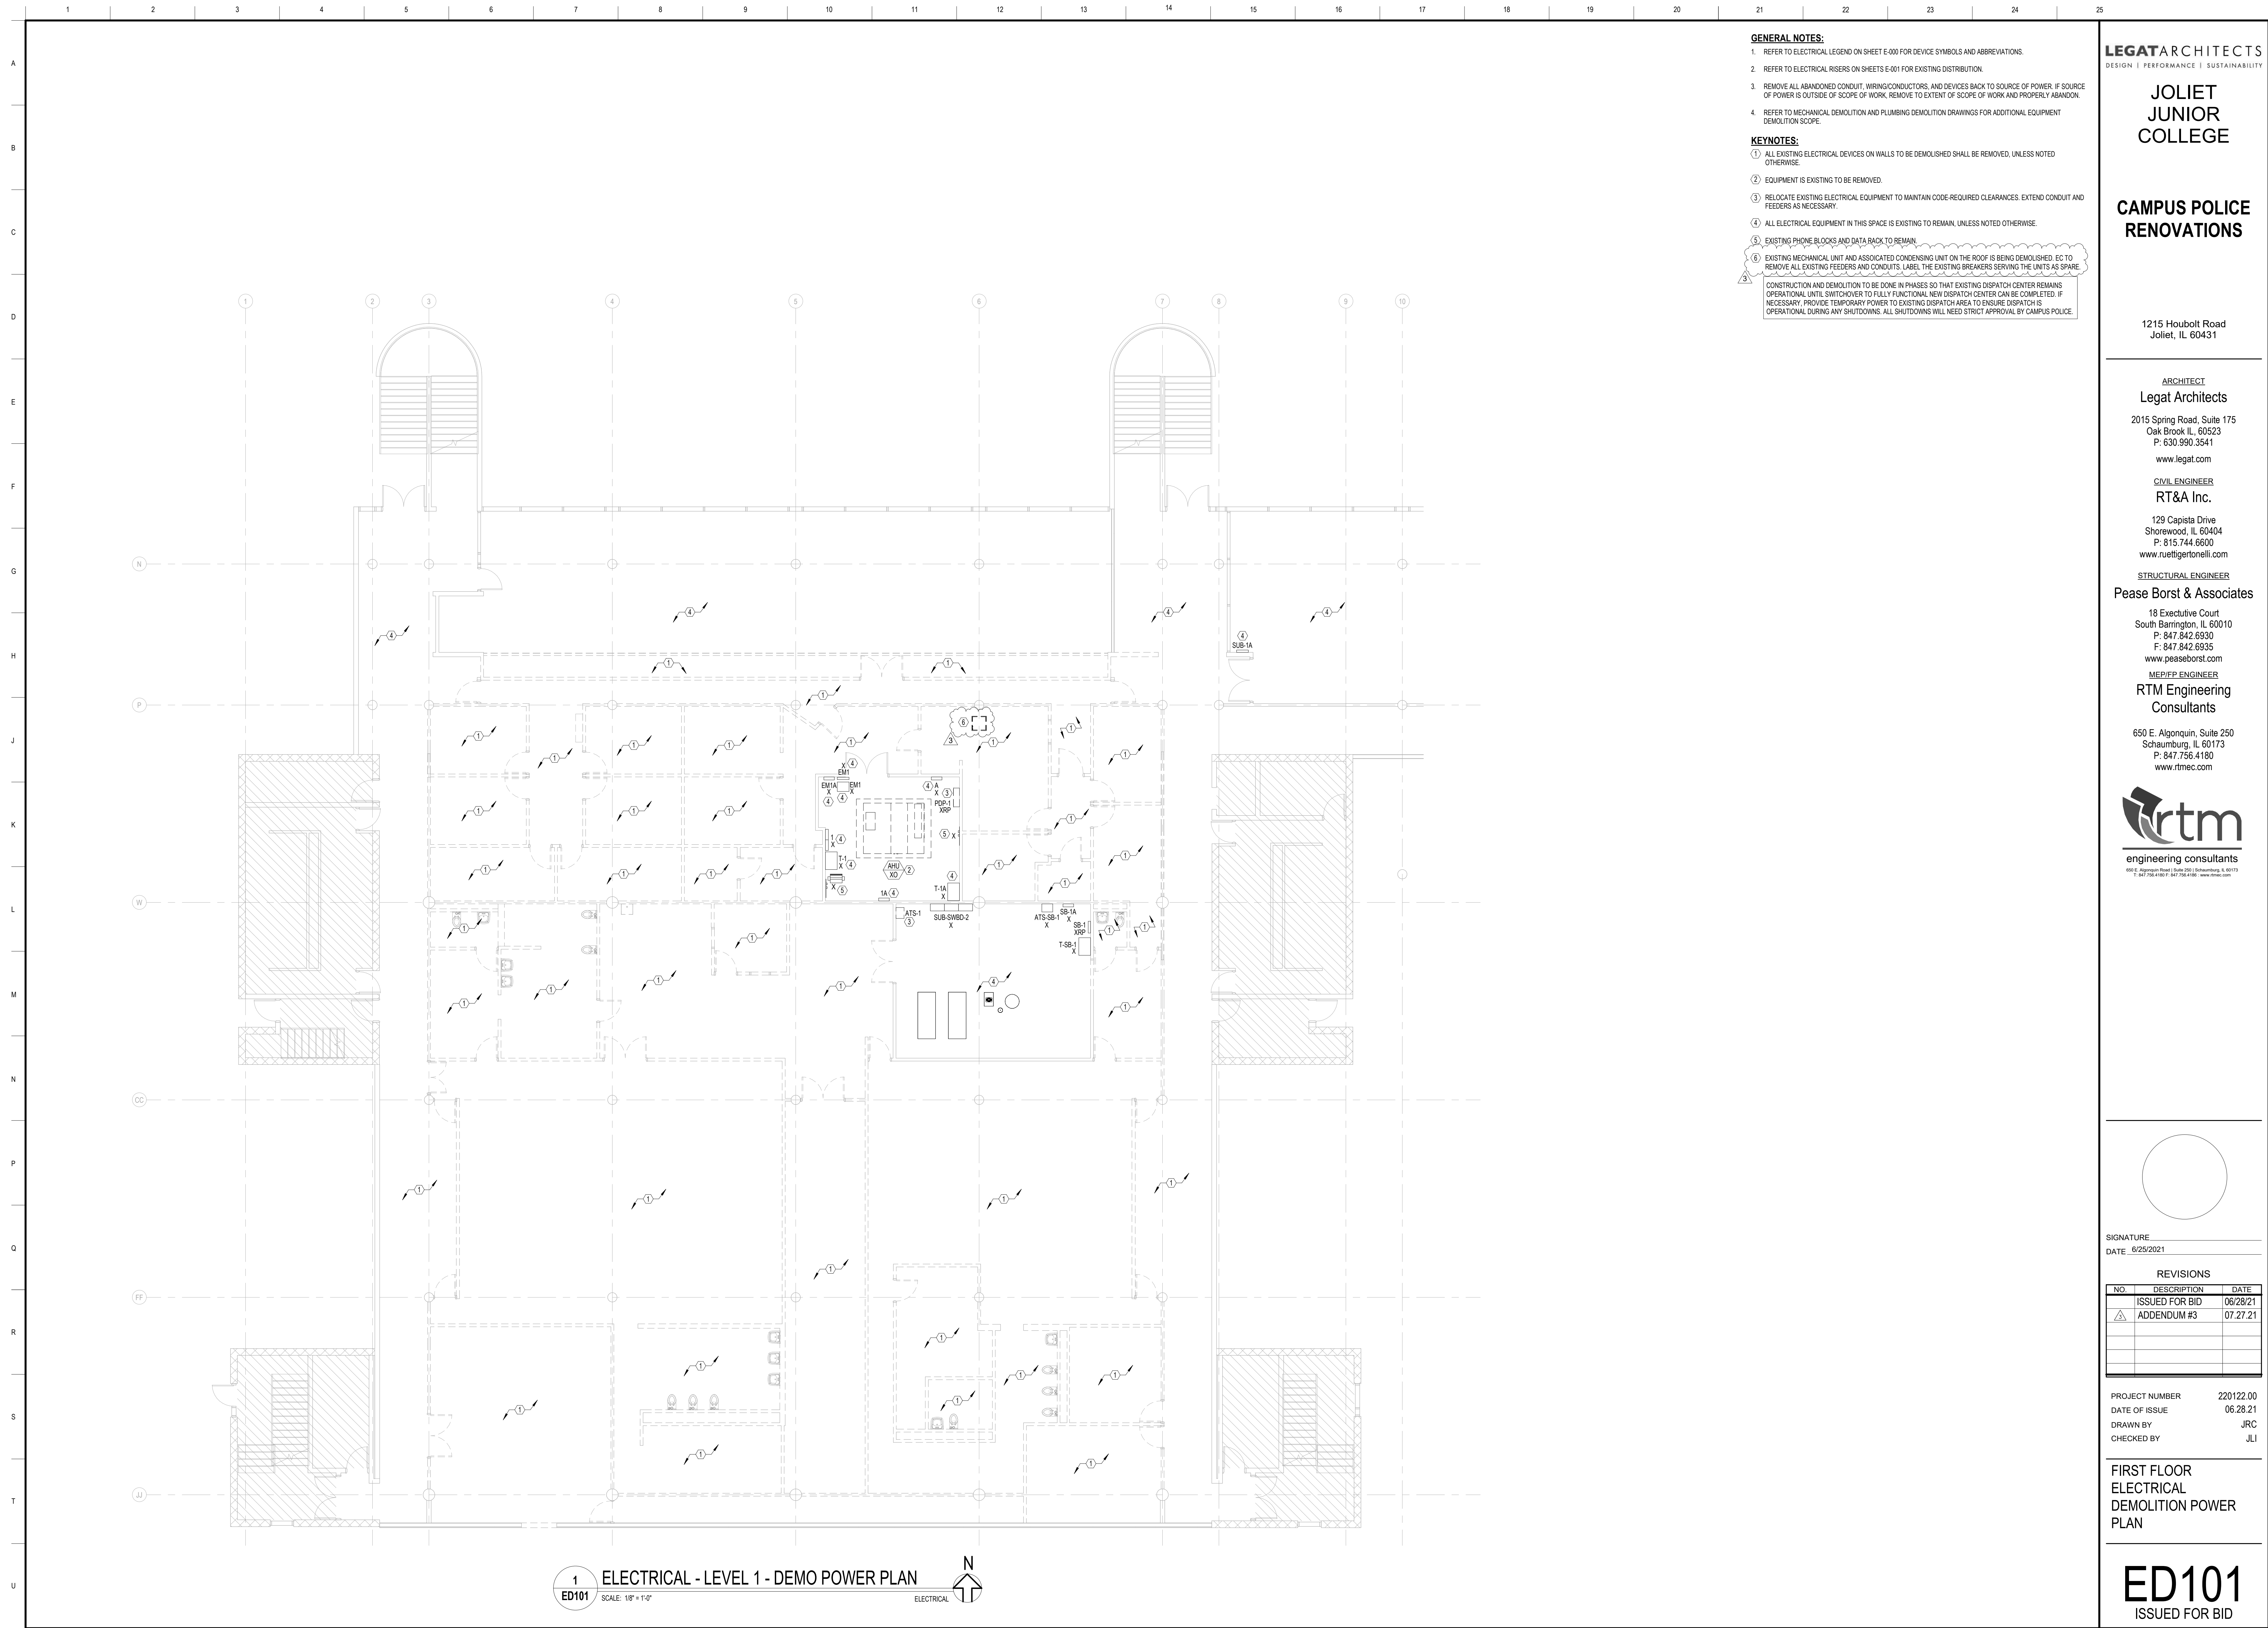

GENERAL NOTES:

- REFER TO ELECTRICAL LEGEND ON SHEET E-000 FOR DEVICE SYMBOLS AND ABBREVIATIONS.
- REFER TO ELECTRICAL RISERS ON SHEETS E-001 FOR EXISTING DISTRIBUTION.
- REMOVE ALL ABANDONED CONDUIT, WIRING/CONDUCTORS, AND DEVICES BACK TO SOURCE OF POWER. IF SOURCE OF POWER IS OUTSIDE OF SCOPE OF WORK, REMOVE TO EXTENT OF SCOPE OF WORK AND PROPERLY ABANDON.
- REFER TO MECHANICAL DEMOLITION AND PLUMBING DEMOLITION DRAWINGS FOR ADDITIONAL EQUIPMENT DEMOLITION SCOPE.

KEYNOTES:

- ALL EXISTING ELECTRICAL DEVICES ON WALLS TO BE DEMOLISHED SHALL BE REMOVED, UNLESS NOTED OTHERWISE.
- EQUIPMENT IS EXISTING TO BE REMOVED.
- RELOCATE EXISTING ELECTRICAL EQUIPMENT TO MAINTAIN CODE-REQUIRED CLEARANCES. EXTEND CONDUIT AND FEEDERS AS NECESSARY.
- ALL ELECTRICAL EQUIPMENT IN THIS SPACE IS EXISTING TO REMAIN, UNLESS NOTED OTHERWISE.
- EXISTING PHONE BLOCKS AND DATA RACK TO REMAIN.
- EXISTING MECHANICAL UNIT AND ASSOCIATED CONDENSING UNIT ON THE ROOF IS BEING DEMOLISHED. EC TO REMOVE ALL EXISTING FEEDERS AND CONDUITS. LABEL THE EXISTING BREAKERS SERVING THE UNITS AS SPARE.

CONSTRUCTION AND DEMOLITION TO BE DONE IN PHASES SO THAT EXISTING DISPATCH CENTER REMAINS OPERATIONAL UNTIL SWITCHOVER TO FULLY FUNCTIONAL NEW DISPATCH CENTER CAN BE COMPLETED. IF NECESSARY, PROVIDE TEMPORARY POWER TO EXISTING DISPATCH AREA TO ENSURE DISPATCH IS OPERATIONAL DURING ANY SHUTDOWNS. ALL SHUTDOWNS WILL NEED STRICT APPROVAL BY CAMPUS POLICE.

LEGAT ARCHITECTS
DESIGN | PERFORMANCE | SUSTAINABILITY

JOLIET JUNIOR COLLEGE

CAMPUS POLICE RENOVATIONS

1215 Houbolt Road
Joliet, IL 60431

ARCHITECT
Legat Architects
2015 Spring Road, Suite 175
Oak Brook, IL, 60523
P: 630.990.3541
www.legat.com

CIVIL ENGINEER
RT&A Inc.
129 Capista Drive
Shorewood, IL 60404
P: 815.744.5600
www.ruettigertonnelli.com

STRUCTURAL ENGINEER
Pease Borst & Associates
18 Executive Court
South Barrington, IL 60010
P: 847.842.6930
F: 847.842.6935
www.peaseborst.com

MED/PEP ENGINEER
RTM Engineering Consultants
650 E. Algonquin, Suite 250
Schaumburg, IL 60173
P: 847.756.4180
www.rtmec.com

engineering consultants
650 E. Algonquin Road | Suite 250 | Schaumburg, IL 60173
T: 847.756.4180 | F: 847.756.4188 | www.rtmec.com

SIGNATURE _____
DATE: 5/25/2021


REVISIONS

NO.	DESCRIPTION	DATE
1	ISSUED FOR BID	06/28/21
2	ADDENDUM #3	07.27.21

PROJECT NUMBER 220122.00
DATE OF ISSUE 06.28.21
DRAWN BY JRC
CHECKED BY JLI

**FIRST FLOOR
ELECTRICAL
DEMOLITION POWER
PLAN**

ED101
ISSUED FOR BID

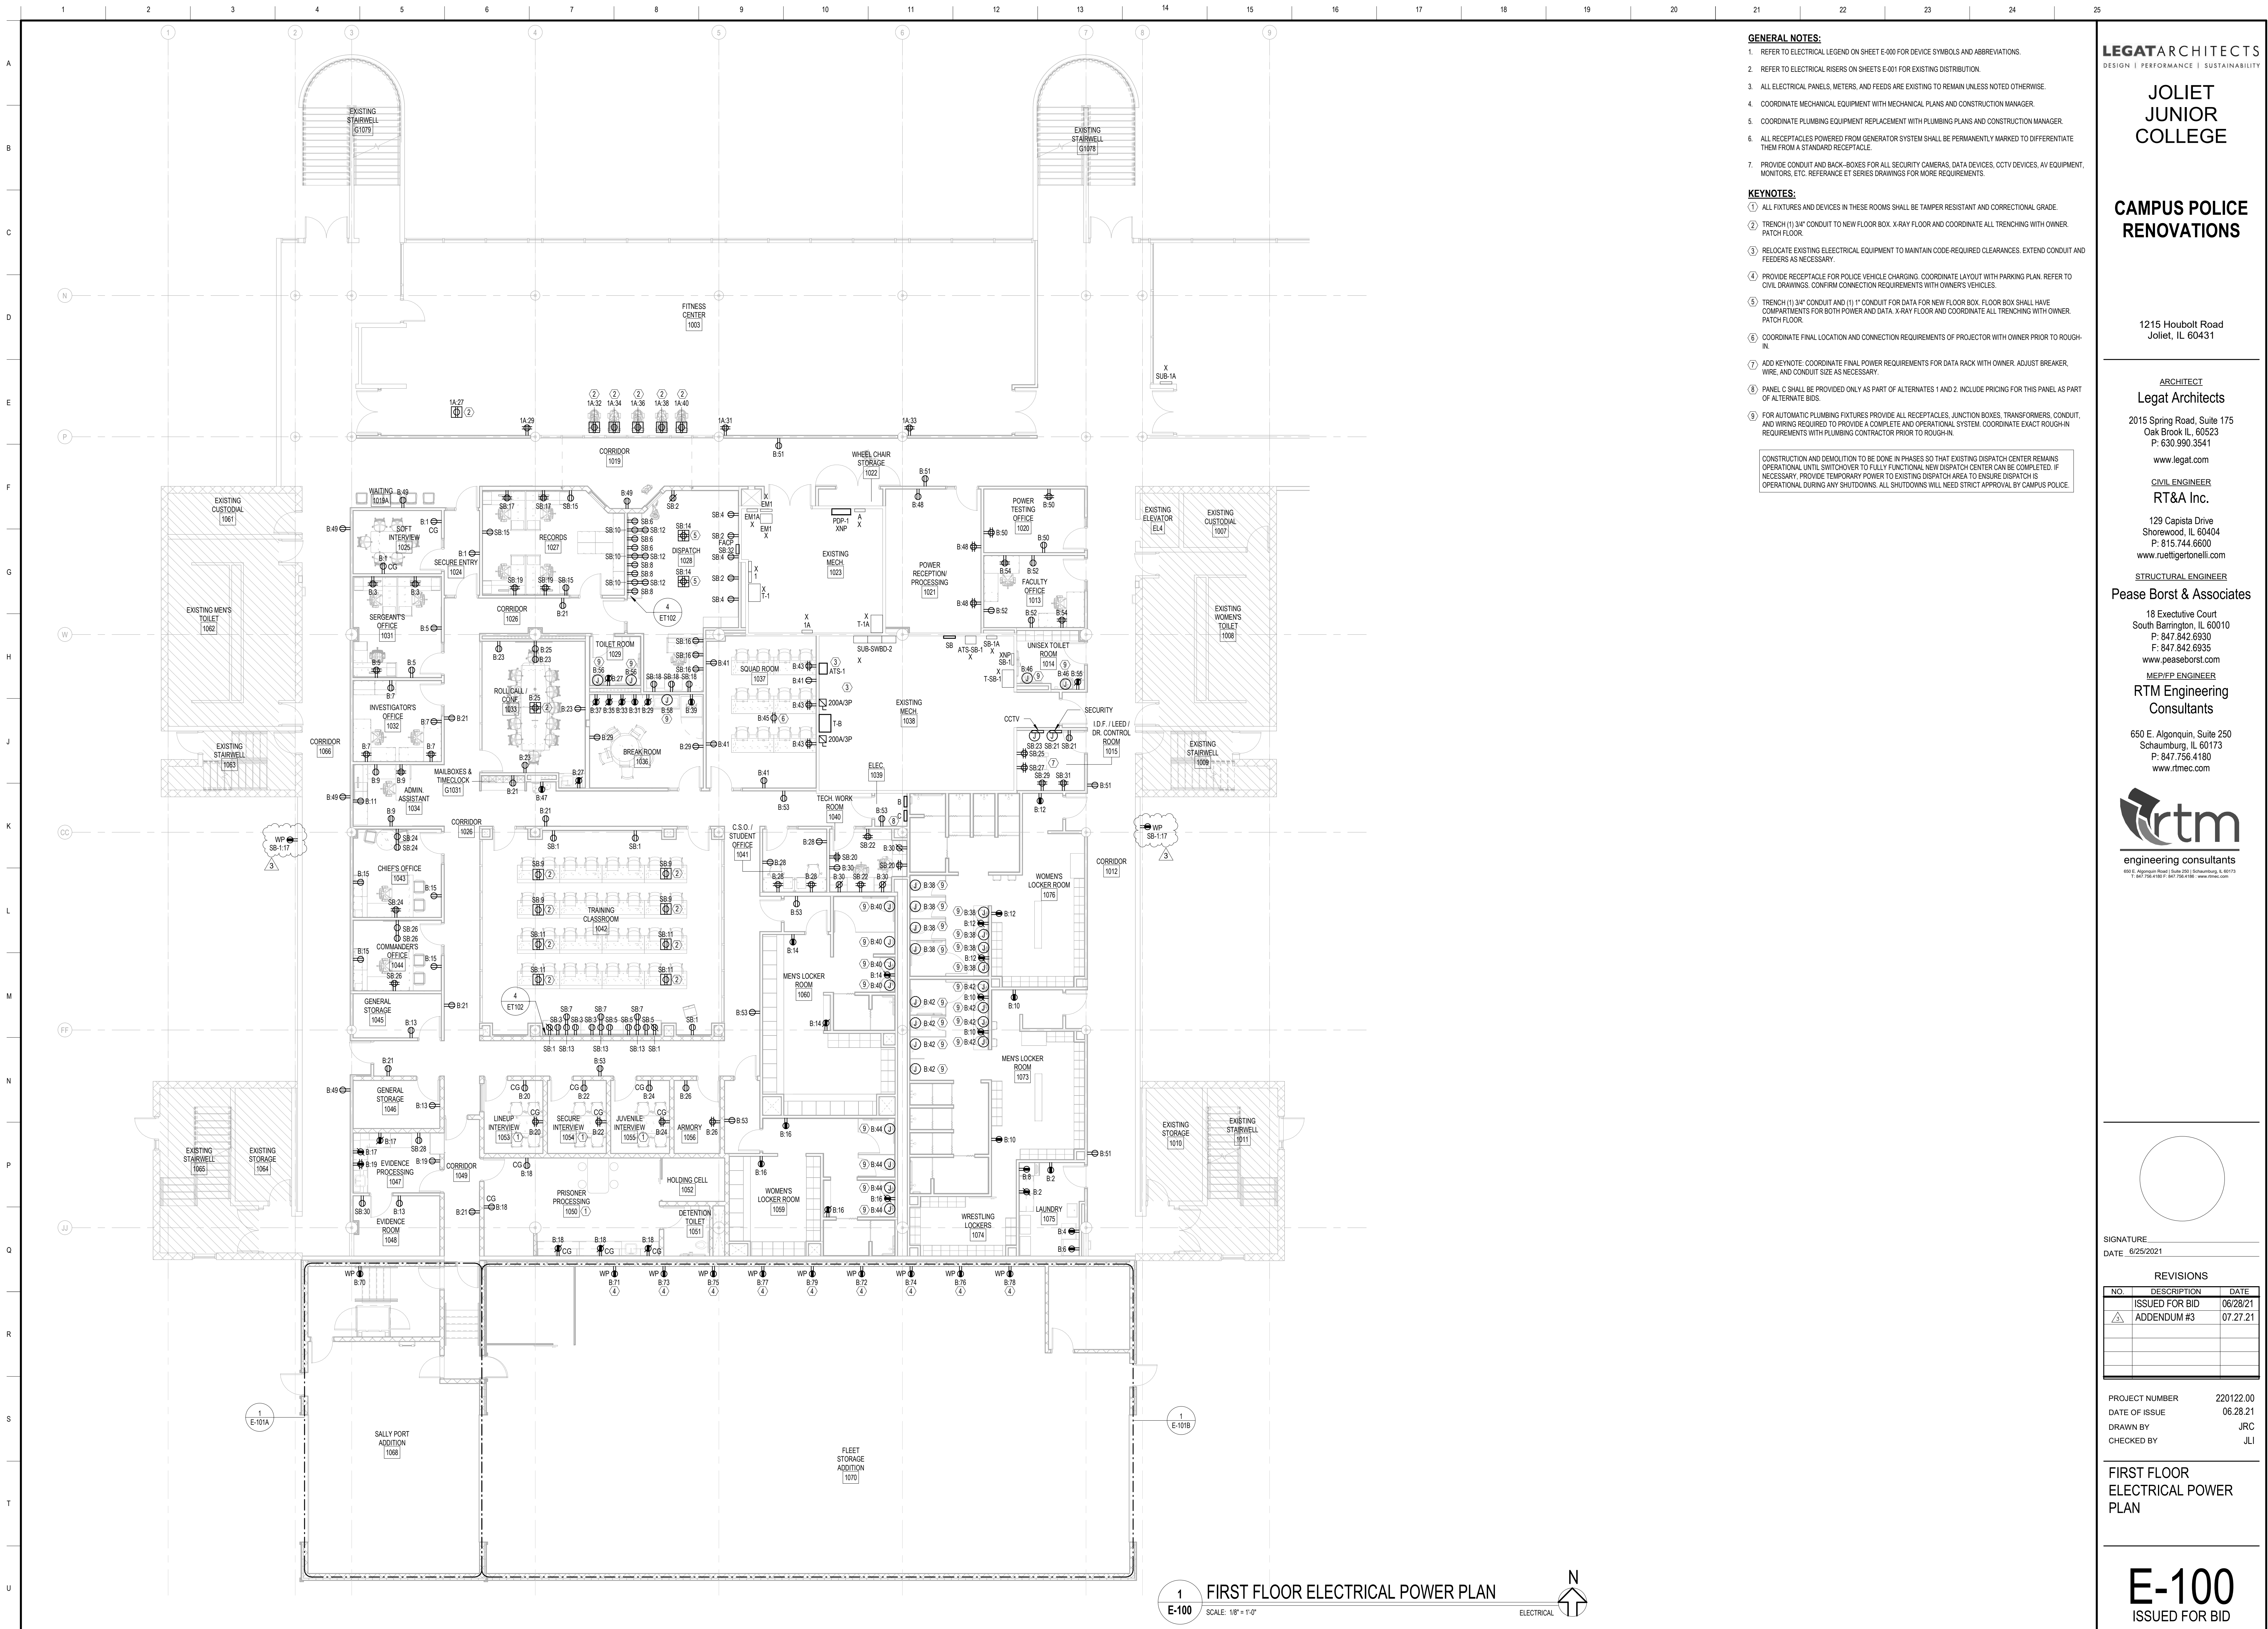

- GENERAL NOTES:**
- REFER TO ELECTRICAL LEGEND ON SHEET E-000 FOR DEVICE SYMBOLS AND ABBREVIATIONS.
 - REFER TO ELECTRICAL RISERS ON SHEETS E-001 FOR EXISTING DISTRIBUTION.
 - ALL ELECTRICAL PANELS, METERS, AND FEEDS ARE EXISTING TO REMAIN UNLESS NOTED OTHERWISE.
 - COORDINATE MECHANICAL EQUIPMENT WITH MECHANICAL PLANS AND CONSTRUCTION MANAGER.
 - COORDINATE PLUMBING EQUIPMENT REPLACEMENT WITH PLUMBING PLANS AND CONSTRUCTION MANAGER.
 - ALL RECEPTACLES POWERED FROM GENERATOR SYSTEM SHALL BE PERMANENTLY MARKED TO DIFFERENTIATE THEM FROM A STANDARD RECEPTACLE.
 - PROVIDE CONDUIT AND BACK-BOXES FOR ALL SECURITY CAMERAS, DATA DEVICES, CCTV DEVICES, AV EQUIPMENT, MONITORS, ETC. REFERENCE ET SERIES DRAWINGS FOR MORE REQUIREMENTS.
- KEYNOTES:**
- ALL FIXTURES AND DEVICES IN THESE ROOMS SHALL BE TAMPER RESISTANT AND CORRECTIONAL GRADE.
 - TRENCH (1) 3/4" CONDUIT TO NEW FLOOR BOX. X-RAY FLOOR AND COORDINATE ALL TRENCHING WITH OWNER. PATCH FLOOR.
 - RELOCATE EXISTING ELECTRICAL EQUIPMENT TO MAINTAIN CODE-REQUIRED CLEARANCES. EXTEND CONDUIT AND FEEDERS AS NECESSARY.
 - PROVIDE RECEPTACLE FOR POLICE VEHICLE CHARGING. COORDINATE LAYOUT WITH PARKING PLAN. REFER TO CIVIL DRAWINGS. CONFIRM CONNECTION REQUIREMENTS WITH OWNERS VEHICLES.
 - TRENCH (1) 3/4" CONDUIT AND (1) 1" CONDUIT FOR DATA FOR NEW FLOOR BOX. FLOOR BOX SHALL HAVE COMPARTMENTS FOR BOTH POWER AND DATA. X-RAY FLOOR AND COORDINATE ALL TRENCHING WITH OWNER. PATCH FLOOR.
 - COORDINATE FINAL LOCATION AND CONNECTION REQUIREMENTS OF PROJECTOR WITH OWNER PRIOR TO ROUGH-IN.
 - ADD KEYNOTE. COORDINATE FINAL POWER REQUIREMENTS FOR DATA RACK WITH OWNER. ADJUST BREAKER, WIRE, AND CONDUIT SIZE AS NECESSARY.
 - PANEL C SHALL BE PROVIDED ONLY AS PART OF ALTERNATES 1 AND 2. INCLUDE PRICING FOR THIS PANEL AS PART OF ALTERNATE BIDS.
 - FOR AUTOMATIC PLUMBING FIXTURES PROVIDE ALL RECEPTACLES, JUNCTION BOXES, TRANSFORMERS, CONDUIT, AND WIRING REQUIRED TO PROVIDE A COMPLETE AND OPERATIONAL SYSTEM. COORDINATE EXACT ROUGH-IN REQUIREMENTS WITH PLUMBING CONTRACTOR PRIOR TO ROUGH-IN.

CONSTRUCTION AND DEMOLITION TO BE DONE IN PHASES SO THAT EXISTING DISPATCH CENTER REMAINS OPERATIONAL UNTIL SWITCHOVER TO FULLY FUNCTIONAL NEW DISPATCH CENTER CAN BE COMPLETED. IF NECESSARY, PROVIDE TEMPORARY POWER TO EXISTING DISPATCH AREA TO ENSURE DISPATCH IS OPERATIONAL DURING ANY SHUTDOWNS. ALL SHUTDOWNS WILL NEED STRICT APPROVAL BY CAMPUS POLICE.

LEGAT ARCHITECTS
DESIGN | PERFORMANCE | SUSTAINABILITY

**JOLIET
JUNIOR
COLLEGE**

**CAMPUS POLICE
RENOVATIONS**

1215 Houbolt Road
Joliet, IL 60431

ARCHITECT

Legat Architects

2015 Spring Road, Suite 175
Oak Brook, IL, 60523
P: 630.990.3541
www.legat.com

CIVIL ENGINEER

RT&A Inc.

129 Capita Drive
Shorewood, IL 60404
P: 815.744.5600
www.ruetigertonnelli.com

STRUCTURAL ENGINEER

Pease Borst & Associates

18 Executive Court
South Barrington, IL 60010
P: 847.842.6930
F: 847.842.6935
www.peaseborst.com

MEDICAL ENGINEER

**RTM Engineering
Consultants**

650 E. Algonquin, Suite 250
Schaumburg, IL 60173
P: 847.756.4180
www.rtmec.com



650 E. Algonquin Road | Suite 250 | Schaumburg, IL 60173
P: 847.756.4180 | F: 847.756.4188 | www.rtmec.com

SIGNATURE
DATE: 8/25/2021


REVISIONS

NO.	DESCRIPTION	DATE
1	ISSUED FOR BID	06/28/21
2	ADDENDUM #3	07.27.21

PROJECT NUMBER 220122.00
DATE OF ISSUE 06.28.21
DRAWN BY JRC
CHECKED BY JLI

**FIRST FLOOR
ELECTRICAL POWER
PLAN**

E-100
ISSUED FOR BID

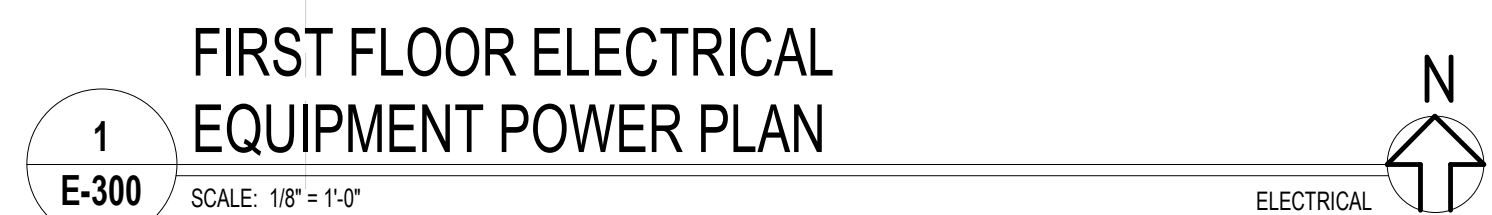


CONSTRUCTION AND DEMOLITION TO BE DONE IN PHASES SO THAT EXISTING DISPATCH CENTER REMAINS OPERATIONAL UNTIL SWITCHOVER TO FULLY FUNCTIONAL NEW DISPATCH CENTER CAN BE COMPLETED. IF NECESSARY, PROVIDE TEMPORARY POWER TO EXISTING DISPATCH AREA TO ENSURE DISPATCH IS OPERATIONAL DURING ANY SHUTDOWNS. ALL SHUTDOWNS WILL NEED STRICT APPROVAL BY CAMPUS POLICE.



650 E. Algonquin Road | Suite 250 | Schaumburg, IL 60173
T: 847.736.4160 F: 847.736.4160 • www.rtmco.com

E-300
ISSUED FOR BID

	1	2	3	4	5	6	7	8	9	10	11	12	13	14	15	16	17	18	19	20	21	22	23	24	25												
A	GYM AIR HANDLING UNIT SCHEDULE																																				
B	TAG	QUANTITY	LOCATION	DESIGN AIR TEMPERATURES		HEATING FLUID TYPE	COOLING FLUID TYPE	COOLING COIL						HEATING COIL						FAN MOTOR DATA				ELECTRICAL				MANUFACTURER	MODEL NO.	WEIGHT (LB)	REMARKS						
				SUMMER				EDB (°F)	EWB (°F)	LDB (°F)	LWB (°F)	TOTAL COOLING CAPACITY (MBH)	SENSIBLE CAPACITY (MBH)	ENT FLUID TEMP (°F)	LVG FLUID TEMP (°F)	FLOW RATE (GPM)	WPD (FT)	EDB (°F)	LDB (°F)	CAPACITY (MBH)	ENT FLUID TEMP (°F)	LVG FLUID TEMP (°F)	FLOW RATE (GPM)	HEATING FLUID PD (FT H2O)	DESIGN AIRFLOW (CFM)	SUPPLY FAN ESP (IN. H2O)	NUMBER OF FANS	SUPPLY FAN MOTOR BHP									
				DB°F	WB°F	DB°F																				FLA	MCA	MOCP	VPH/Hz								
B	AHU-G1, AHU-G2, AHU-G3, AHU-G4, AHU-G5, AHU-G6	6	EXISTING GYM	89.7	74.4	3.4	WATER	30% EG	78.4	64.7	55.1	54.2	158	129	42	54	27.8	12.8	56	98	249.15	180	140	12.7	1.8	5,200	0.75	2.0	2.3	15.4	17.3	25	460/360	CARRIER	39MN	2158	ALL
C	REMARKS: 1. INSTALL PER MANUFACTURER'S RECOMMENDATIONS. PROVIDE FACTORY STARTUP AND COMPLETE WRITTEN REPORT. 2. DIRECT DRIVE PLENUM FANS. 3. FILTER SECTION, 2" MERV 9 PLEATED MEDIA FILTERS - PROVIDE (2) SETS. 4. FACTORY INSTALLED VFD'S - 3 YEAR PARTS AND LABOR WARRANTY ON VFD'S. START-UP BY MANUFACTURER. 5. MOTOR SHAFT GROUNDING RINGS. 6. ASHRAE 111 CLASS 6 LEAKAGE CASING (<1.0 PERCENT LEAKAGE) AND PANEL DEFLECTION LESS THAN 0.0042 INCHES AT +/- 8 INCHES W.G. 7. 2 INCH R13 FOMAN INJECTED CASING. NO THROUGH-METAL CASING. THERMAL BREAKS DOORS. TR VALUE OF 0.6. 8. STAINLESS STEEL COOLING COIL CASING. 9. UL LISTING. 10. RUBIN CDD DAMPERS TESTED IN COMPLIANCE WITH AMCA STANDARD 500. 11. PROVIDE EXTENDED DRAIN AND VENT CONNECTIONS THROUGH CASING ON WATER COILS. 12. FULLY PROGRAMMABLE BACNET CONTROLS COMPLETE WITH ALL END-DEVICES, SENSORS, SWITCHES, CONTROL VALVES AND ACTUATORS BY TEMP. CONTROLS CONTRACTOR. 13. OEM FIRST YEAR PARTS AND LABOR WARRANTY - ENTIRE UNIT. 14. EACH MOTOR TO BE PROVIDED WITH INDIVIDUAL MOTOR OVERLOAD PROTECTION. 15. ACTUATORS BY TEMP CONTROLS CONTRACTOR.																																				
D	EXHAUST FAN SCHEDULE																																				
E	TAG	SERVICE	CFM	ESP IN	MOTOR DATA						MANUFACTURER AND MODEL	REMARKS																									
					RPM	DRIVE	HP	VOLT	PH	HZ	WEIGHT																										
E	EF-1059	LOCKER ROOM	475	0.53	1550	DIRECT	1/8	120	1	60	49	GREENHECK SQ-95-D	1, 2, 6																								
E	EF-1060	LOCKER ROOM	475	0.53	1550	DIRECT	1/8	120	1	60	49	GREENHECK SQ-95-D	1, 2, 6																								
E	EF-1073	LOCKER ROOM	475	0.53	1550	DIRECT	1/8	120	1	60	49	GREENHECK SQ-95-D	1, 2, 6																								
E	EF-1076	LOCKER ROOM	475	0.53	1550	DIRECT	1/8	120	1	60	49	GREENHECK SQ-95-D	1, 2, 6																								
E	EF-1023	GENERAL EXHAUST	16515	0.50	509	DIRECT	5	480	3	60	319	GREENHECK GB-420	1, 4, 5, 6																								
E	CEF-1014	TOILET ROOM	70	0.48	935	DIRECT	6 W	120	1	60	47	GREENHECK SP-80-VG	1, 3, 6																								
F	CEF-1029	TOILET ROOM	70	0.48	935	DIRECT	6 W	120	1	60	47	GREENHECK SP-80-VG	1, 3, 6																								
F	CEF-1051	TOILET ROOM	70	0.48	935	DIRECT	6 W	120	1	60	47	GREENHECK SP-80-VG	1, 3, 6																								
G	REMARKS: 1. PROVIDE FAN WITH DISCONNECT SWITCH, BACKDRAFT DAMPER, AND BIRDSCREEN. 2. EXHAUST FAN TO RUN CONTINUOUSLY. 3. EXHAUST FAN TO BE CONTROLLED BY LIGHT SWITCH. 4. EXHAUST FAN TO BE CONTROLLED WITH AHU BY DAS. 5. EXHAUST FAN TO BE CONTROLLED BY VFD. VFD TO BE PROVIDED BY MECHANICAL CONTRACTOR. 6. EXHAUST FAN TO BE PROVIDED WITH EC MOTOR.																																				
H	WEATHER CAP SCHEDULE																																				
	ITEM TAG	SERVES	DESIGN CFM	TYPE	MANUFACTURER	MODEL	REMARKS																														
	CAP 1	EXHAUST	800	EXHAUST	GREENHECK	GRSF	ALL																														
H	REMARKS: 1. PROVIDE BACKDRAFT DAMPER AND BIRDSCREEN AT CONNECTION TO CAP. 2. FLASH CAP CURB INTO ROOF. CURB TO BE A MINIMUM OF 24".																																				
I	GRILLE, REGISTERS, AND DIFFUSER SCHEDULE																																				
J	ITEM TAG	AIR STREAM	MOUNTING TYPE	FRAME SIZE		MANUFACTURER	MODEL	REMARKS																													
				HEIGHT (IN)	WIDTH (IN)																																
J	A	SUPPLY	SQUARE	24	24	TITUS	OMNI	1-5																													
J	B	RETURN	SQUARE	24	24	TITUS	PAR	2, 4, 6																													
J	C	EXHAUST	SQUARE	12	12	TITUS	PAR-AA	2, 4, 5																													
J	D	RETURN	RECTANGULAR	24	12	TITUS	PAR	2, 4, 6																													
J	E	EXHAUST	SQUARE	24	24	TITUS	PAR-AA	2, 4, 5																													
J	F	SUPPLY	SQUARE	24	24	TITUS	SG-SD	1-5, 7																													
J	G	RETURN	RECTANGULAR	24	12	TITUS	SG-SD	2, 4, 6, 7																													
J	H	RETURN	SQUARE	24	24	TITUS	SG-SD	2, 4, 6, 7																													
J	J	SUPPLY	SQUARE	24	24	PRICE	AMDC	1-5																													
J	K	TRANSFER	SQUARE	24	24	TITUS	PAR	1-5																													
K	REMARKS: 1. 4 WAY THROW UNLESS OTHERWISE NOTED. 2. PROVIDE ADAPTOR BOOTS AS REQUIRED. 3. PROVIDE WITH MANUAL VOLUM BALANCE DAMPER. 4. COORDINATE FRAME STYLES WITH ARCHITECTURAL PLANS. 5. REFER TO PLAN FOR FACE AND DUCT SIZING. 6. RETURN GRILLE TO HAVE LINED ELBOW BOOT FOR PLENUM RETURN AND SOUND ATTENUATION. 7. GRILLE TO BE ANTI-LIGATURE DEVICE.																																				
L	MOTORIZED CONTROL VALVE SCHEDULE																																				
M	TAG	DESIGN FLOW (GPM)	MAX DIFFERENTIAL PRESSURE (PSI)	PIPE SIZE (IN)	FAIL POSITION	ELECTRICAL DATA			MANUFACTURER	MODEL NO.	REMARKS																										
						VOLTS	PH	HZ																													
M	CV 1A	137.1	60	3	FAIL IN LAST POSITION (F.L.P)	120	1	60	BELIMO	P6300S	ALL																										
M	CV 1B	70	60	2.5	FAIL OPEN	120	1	60	BELIMO	P6250S	ALL																										
M	CV 1003A	2	60	0.75	FAIL IN LAST POSITION (F.L.P)	120	1	60	BELIMO	B220HT	ALL																										
M	CV 1003B	2	60	0.75	FAIL IN LAST POSITION (F.L.P)	120	1	60	BELIMO	B220HT	ALL																										
M	CV 1003C	0.6	60	0.5	FAIL IN LAST POSITION (F.L.P)	120	1	60	BELIMO	B220HT	ALL																										
M	CV 1008	1	60	0.75	FAIL IN LAST POSITION (F.L.P)	120	1	60	BELIMO	B220HT	ALL																										
M	CV 1012	1.4	60	0.75	FAIL IN LAST POSITION (F.L.P)	120	1	60	BELIMO	B220HT	ALL																										
M	CV 1021	0.7	60	0.75	FAIL IN LAST POSITION (F.L.P)	120	1	60	BELIMO	B220HT	ALL																										
M	CV 1027	0.3	60	0.75	FAIL IN LAST POSITION (F.L.P)	120	1	60	BELIMO	B220HT	ALL																										
M	CV 1028	0.6	60	0.75	FAIL IN LAST POSITION (F.L.P)	120	1	60	BELIMO	B220HT	ALL																										
M	CV 1031	0.6	60	0.75	FAIL IN LAST POSITION (F.L.P)	120	1	60	BELIMO	B220HT	ALL																										
M	CV 1034	0.5	60	0.75	FAIL IN LAST POSITION (F.L.P)	120	1	60	BELIMO	B220HT	ALL																										
M	CV 1036	1	60	0.75	FAIL IN LAST POSITION (F.L.P)	120	1	60	BELIMO	B220HT	ALL																										
M	CV 1037	0.7	60	0.75	FAIL IN LAST POSITION (F.L.P)	120	1	60	BELIMO	B220HT	ALL																										
M	CV 1041	0.3	60	0.75	FAIL IN LAST POSITION (F.L.P)	120	1	60	BELIMO	B220HT	ALL																										
M	CV 1042	2.1	60	0.75	FAIL IN LAST POSITION (F.L.P)	120	1	60	BELIMO	B220HT	ALL																										
N	REMARKS: 1. CONTROL VALVE TO BE WIRED AND CONNECTED PER CONTROL DRAWINGS. 2. CONTROL VALVE TO BE ON SUPPLY SIDE OF COIL. 3. CONTROL VALVE TO RECEIVE POWER FROM A 24V DC TRANSFORMER WITH POWER CONDITIONER. PROVIDED BY E.C																																				
P	VARIABLE AIR VOLUME TERMINAL UNIT SCHEDULE WITH HOT WATER REHEAT																																				
Q	TAG	NECK SIZE (IN)	DESIGN AIRFLOW		HEATING AIRFLOW (CFM)	HEATING CAP.				CONTROL TYPE	MANUFACTURER	MODEL NO.	WEIGHT (LB)	REMARKS																							
			MAX (CFM)	MIN (CFM)		MBH	GPM	EAT (°F)	LAT (°F)																												
								EWL (°F)	LWT (°F)																												
Q	VAV-1003A	16	2490	2490	2490	81.1	5.4	65	95	180	113	0.57	DDC	CARRIER	35E	68	1-8																				
Q	VAV-1003B	16	2490	2490	2490	81.1	5.4	65	95	180	113	0.57	DDC	CARRIER	35E	68	1-8																				
Q	VAV-1003C													REMOVED FROM PROJECT																							
Q	VAV-1008	8	810	245	245	25.4	3.7	65	80	106	128	0.37	DDC	CARRIER	35E	37	1-8																				
Q	VAV-1012	9	1100	330	1100	35.8	1.4	65	95	180	126	0.33	DDC	CARRIER	35E	46	1-8																				
Q	VAV-1021	7	650	195	195	21.1	3.0	65	80	180	120	0.19	DDC	CARRIER	35E	37	1-8																				

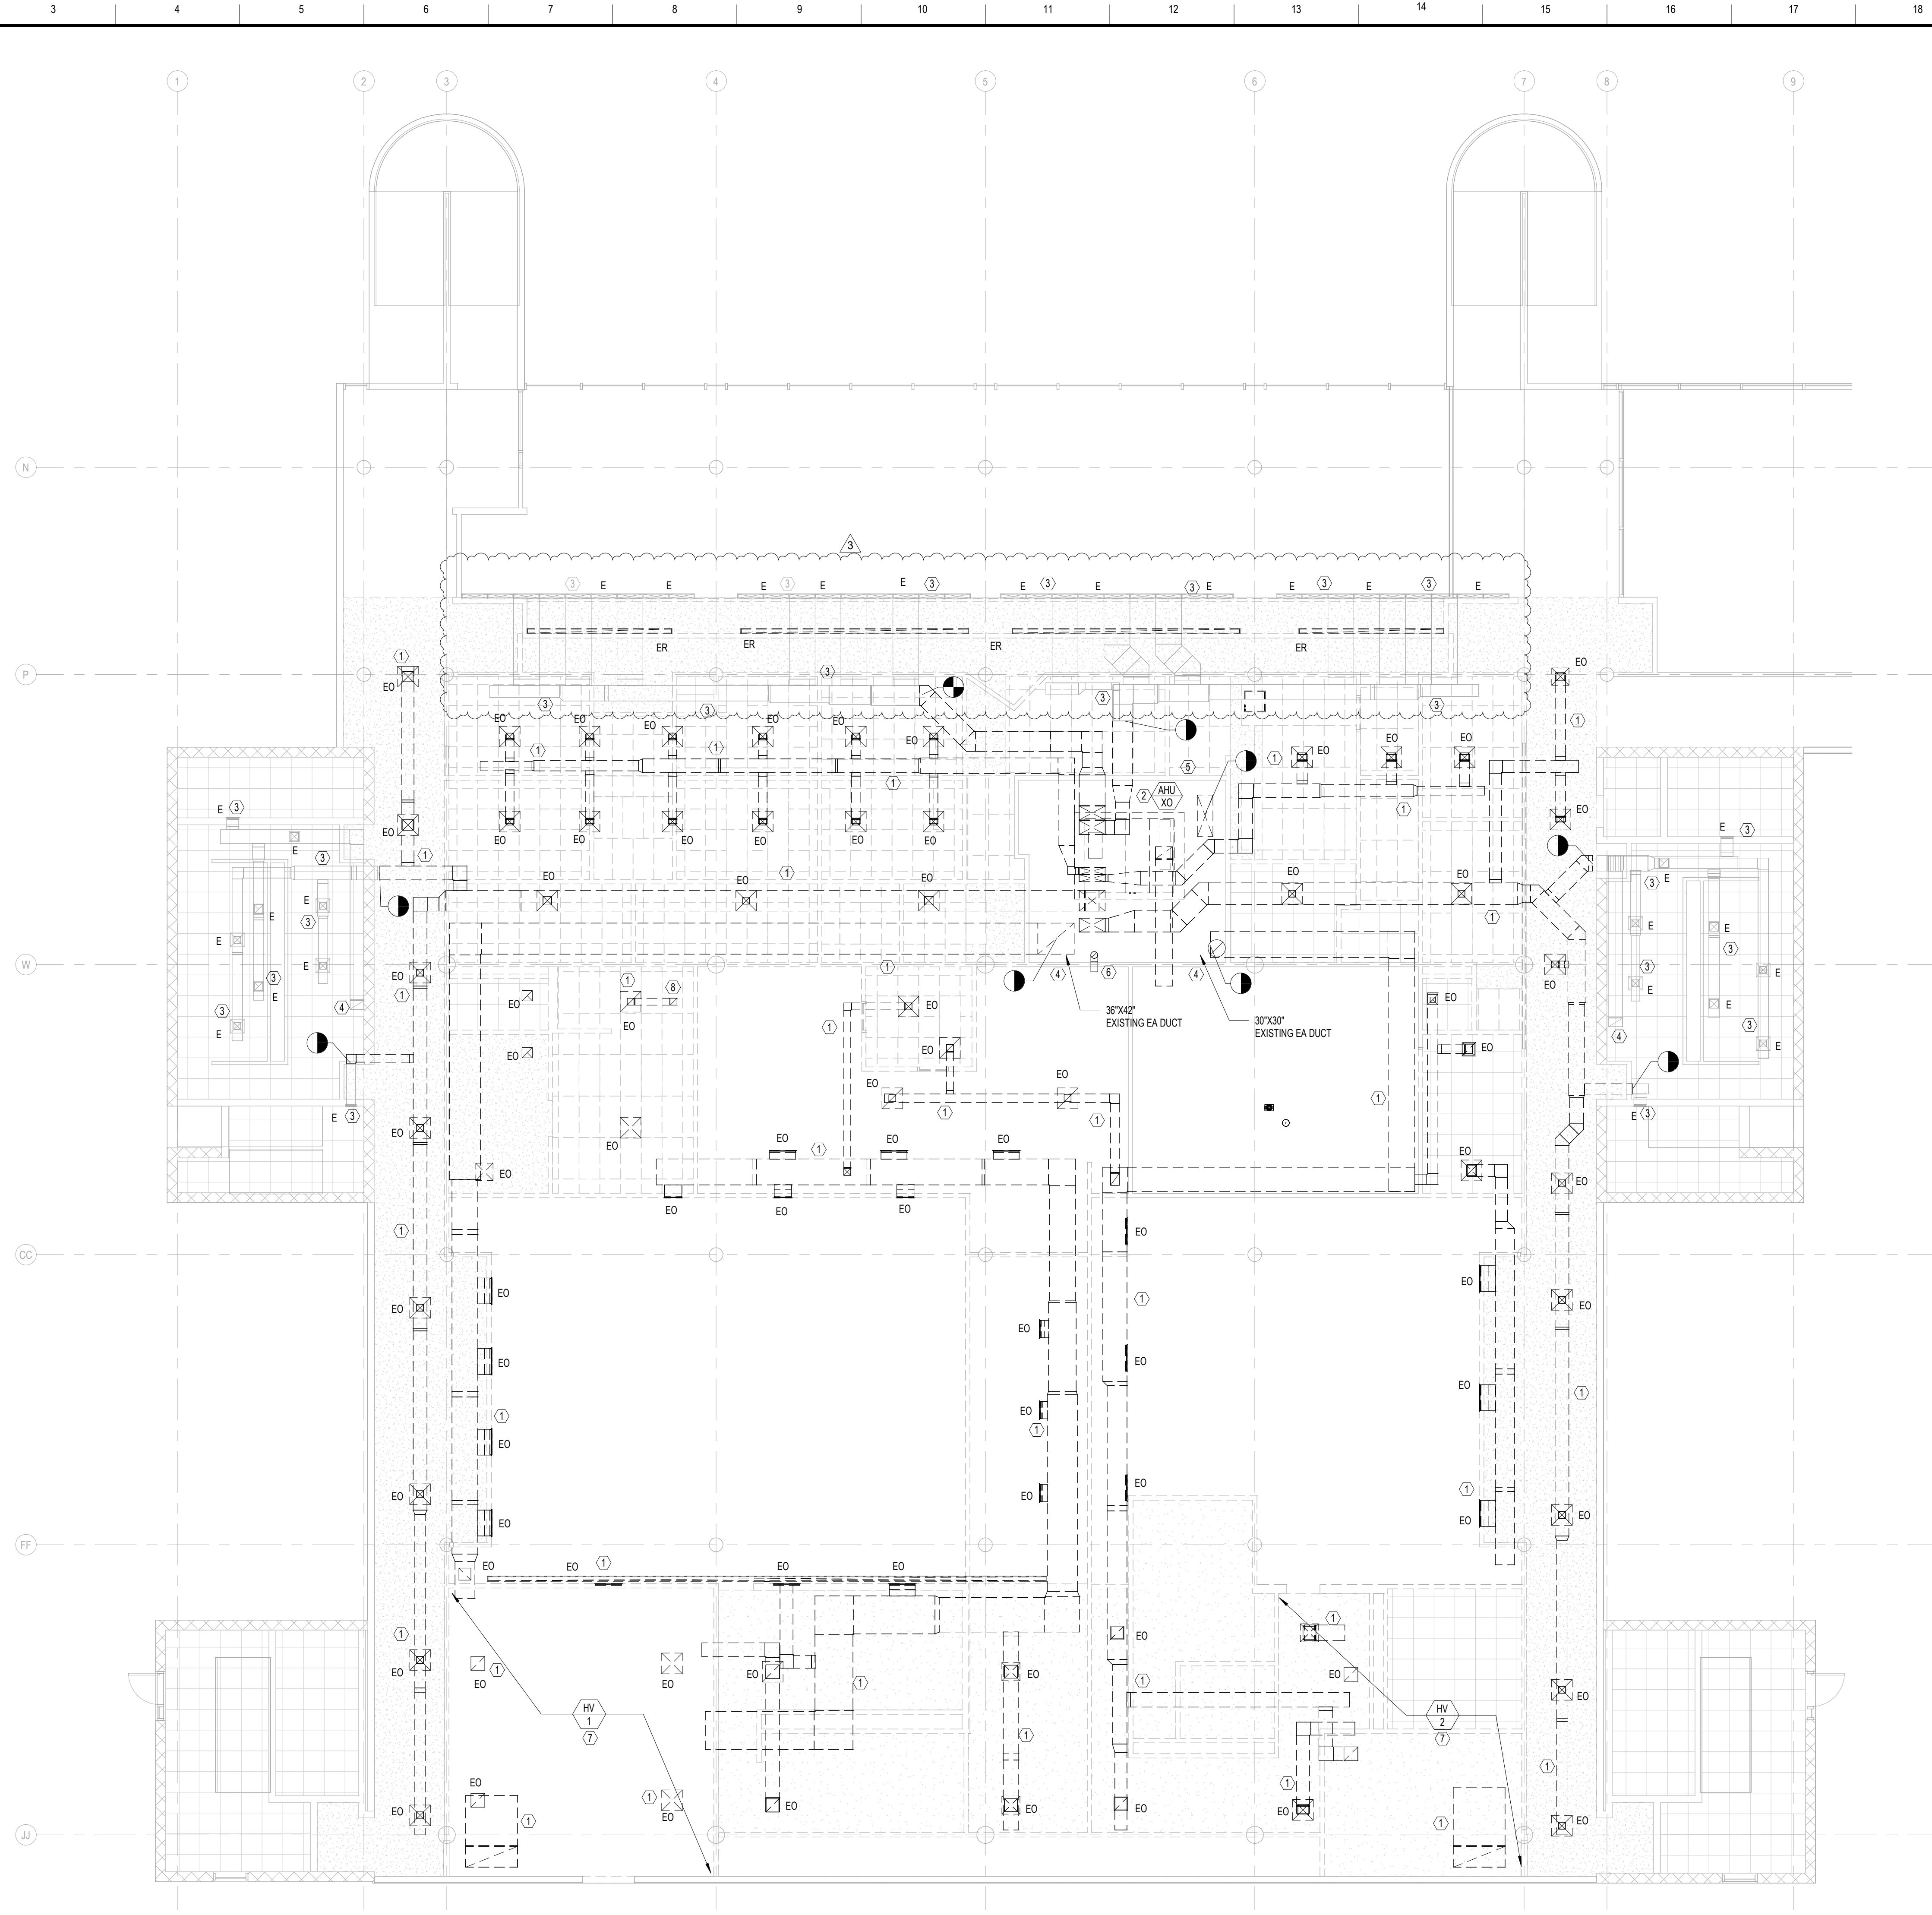

- GENERAL NOTES:**
1. ALL UNUSED DUCTWORK SHALL BE CAPPED BACK TO MAIN.
 2. ALL UNUSED EQUIPMENT, HANGERS, DUCTS, SUPPORTS, PIPES, AND WIRING SHALL BE DISCONNECTED, PROPERLY DISPOSED OF, AND REMOVED BACK TO SOURCE.
 3. ALL RESULTING UNUSED OPENINGS IN WALLS, FLOORS, AND CEILINGS DUE TO DEMOLITION SHALL BE PATCHED TO MATCH EXISTING CORRESPONDING MATERIAL.
 4. ALL UNUSED PIPING TO BE CAPPED BACK TO MAIN.
 5. COORDINATE ALL DEMOLITION WITH NEW WORK PLANS.
- KEYNOTES:**
- ① EXISTING DUCTWORK AND DIFFUSERS TO BE DEMOLISHED.
 - ② EXISTING AHU TO BE DEMOLISHED ALONG WITH ALL HYDRONIC CONNECTIONS, DUCTWORK, AND ELECTRICAL CONNECTIONS. CAP HYDRONIC PIPING IN SUCH A WAY TO ALLOW FOR NEW AHU TO CONNECT INTO EXISTING HYDRONIC SYSTEM.
 - ③ EXISTING DUCTWORK AND DIFFUSERS TO REMAIN.
 - ④ EXISTING EXHAUST RISER TO REMAIN.
 - ⑤ EXISTING OUTSIDE AIR RISER TO REMAIN.
 - ⑥ EXISTING 8" DRYER EXHAUST DUCT TO BE DEMOLISHED AND CAPPED BACK AT ROOF.
 - ⑦ EXISTING LOCKER ROOM UNIT TO BE DEMOLISHED ALONG WITH HYDRONIC CONNECTIONS, DUCTWORK, AND ELECTRICAL CONNECTIONS. CAP HYDRONIC PIPING BACK AT MAIN.
 - ⑧ EXISTING EXHAUST FAN LOCATED ON ROOF SERVING BATHROOM TO BE DEMOLISHED ALONG WITH ALL SUPPORTS, ELECTRICAL, AND DUCTWORK. PATCH ROOF TO MATCH EXISTING.

CONSTRUCTION AND DEMOLITION TO BE DONE IN PHASES SO THAT EXISTING DISPATCH CENTER REMAINS OPERATIONAL UNTIL SWITCHOVER TO FULLY FUNCTIONAL NEW DISPATCH CENTER CAN BE COMPLETED.

FIRST FLOOR MECHANICAL DEMOLITION PLAN
1
MD101
SCALE: 1/8" = 1'-0"
MECHANICAL

LEGAT ARCHITECTS
DESIGN | PERFORMANCE | SUSTAINABILITY

JOLIET JUNIOR COLLEGE

CAMPUS POLICE RENOVATIONS

1215 Houbolt Road
Joliet, IL 60431

ARCHITECT

Legat Architects

2015 Spring Road, Suite 175
Oak Brook IL, 60523
P: 630.990.3541
www.legat.com

CIVIL ENGINEER

RT&A Inc.

129 Capita Drive
Shorewood, IL 60404
P: 815.744.5600
www.ruettigertonnelli.com

STRUCTURAL ENGINEER

Pease Borst & Associates


18 Executive Court
South Barrington, IL 60010
P: 847.842.6930
F: 847.842.6935
www.peaseborst.com

MEP/FP ENGINEER

RTM Engineering
Consultants

650 E. Algonquin, Suite 250
Schaumburg, IL 60173
P: 847.756.4180
www.rtmec.com

rtm
engineering consultants
650 E. Algonquin Road | Suite 250 | Schaumburg, IL 60173
T: 847.756.4180 F: 847.756.4188 www.rtmec.com

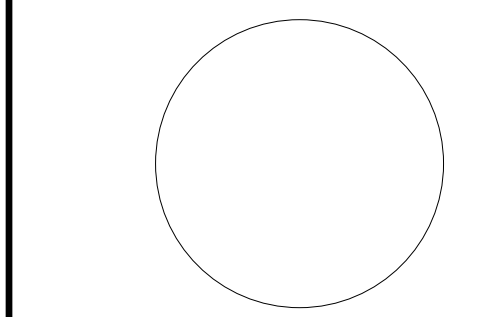

SIGNATURE
DATE: 6/28/2021


REVISIONS

NO.	DESCRIPTION	DATE
	ISSUED FOR BID	06/28/21
Δ	ADDENDUM #3	07.27.21

PROJECT NUMBER 220122.00
DATE OF ISSUE 06.28.21
DRAWN BY MB/BD
CHECKED BY DP

FIRST FLOOR
MECHANICAL
DEMOLITION PLAN

MD101
ISSUED FOR BID

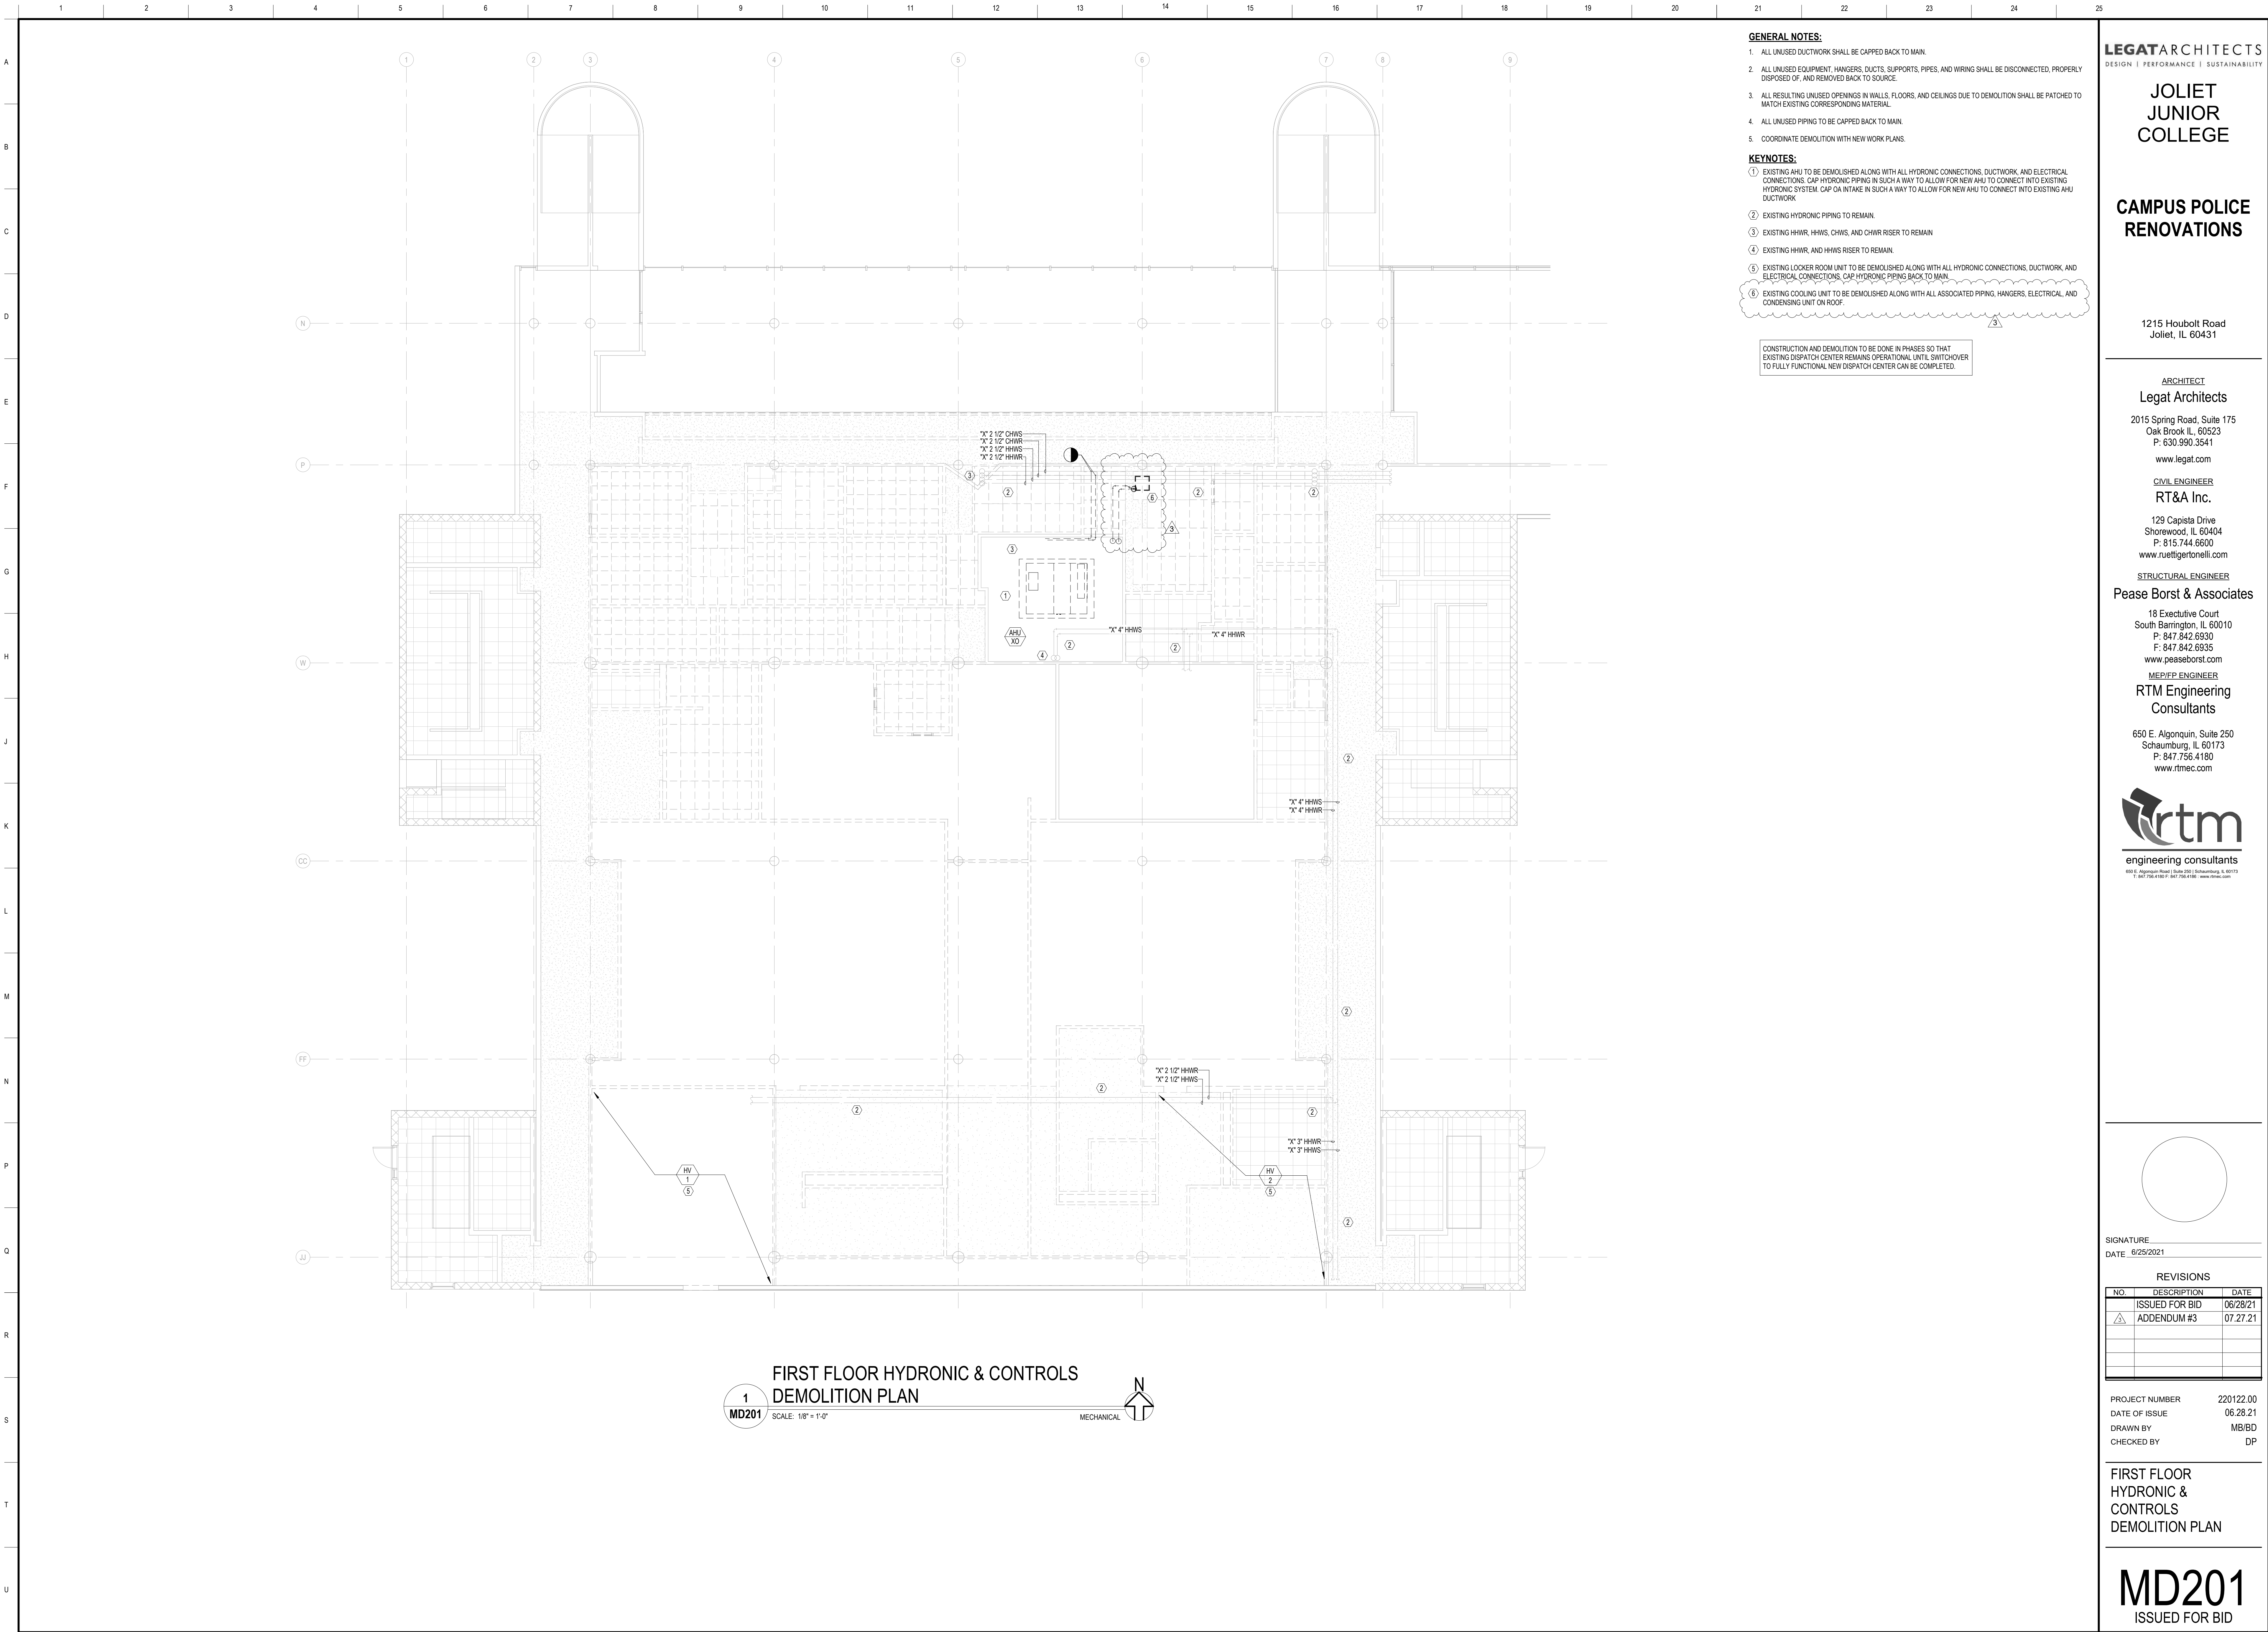

GENERAL NOTES:

1. ALL UNUSED DUCTWORK SHALL BE CAPPED BACK TO MAIN.
2. ALL UNUSED EQUIPMENT, HANGERS, DUCTS, SUPPORTS, PIPES, AND WIRING SHALL BE DISCONNECTED, PROPERLY DISPOSED OF, AND REMOVED BACK TO SOURCE.
3. ALL RESULTING UNUSED OPENINGS IN WALLS, FLOORS, AND CEILINGS DUE TO DEMOLITION SHALL BE PATCHED TO MATCH EXISTING CORRESPONDING MATERIAL.
4. ALL UNUSED PIPING TO BE CAPPED BACK TO MAIN.
5. COORDINATE DEMOLITION WITH NEW WORK PLANS.

KEYNOTES:

- ① EXISTING AHU TO BE DEMOLISHED ALONG WITH ALL HYDRONIC CONNECTIONS, DUCTWORK, AND ELECTRICAL CONNECTIONS. CAP HYDRONIC PIPING IN SUCH A WAY TO ALLOW FOR NEW AHU TO CONNECT INTO EXISTING HYDRONIC SYSTEM. CAP OA INTAKE IN SUCH A WAY TO ALLOW FOR NEW AHU TO CONNECT INTO EXISTING AHU DUCTWORK.
- ② EXISTING HYDRONIC PIPING TO REMAIN.
- ③ EXISTING HHWR, HHWS, CHWS, AND CHWR RISER TO REMAIN.
- ④ EXISTING HHWR, AND HHWS RISER TO REMAIN.
- ⑤ EXISTING LOCKER ROOM UNIT TO BE DEMOLISHED ALONG WITH ALL HYDRONIC CONNECTIONS, DUCTWORK, AND ELECTRICAL CONNECTIONS. CAP HYDRONIC PIPING BACK TO MAIN.
- ⑥ EXISTING COOLING UNIT TO BE DEMOLISHED ALONG WITH ALL ASSOCIATED PIPING, HANGERS, ELECTRICAL, AND CONDENSING UNIT ON ROOF.

CONSTRUCTION AND DEMOLITION TO BE DONE IN PHASES SO THAT EXISTING DISPATCH CENTER REMAINS OPERATIONAL UNTIL SWITCHOVER TO FULLY FUNCTIONAL NEW DISPATCH CENTER CAN BE COMPLETED.

LEGAT ARCHITECTS
DESIGN | PERFORMANCE | SUSTAINABILITY

JOLIET JUNIOR COLLEGE

CAMPUS POLICE RENOVATIONS

1215 Houbolt Road
Joliet, IL 60431

ARCHITECT
Legat Architects
2015 Spring Road, Suite 175
Oak Brook, IL, 60523
P: 630.990.3541
www.legat.com

CIVIL ENGINEER
RT&A Inc.
129 Capista Drive
Shorewood, IL 60404
P: 815.744.5600
www.ruettigertonnelli.com

STRUCTURAL ENGINEER
Pease Borst & Associates
18 Executive Court
South Barrington, IL 60010
P: 847.842.6930
F: 847.842.6935
www.peaseborst.com

MED/PEP ENGINEER
RTM Engineering Consultants
650 E. Algonquin, Suite 250
Schaumburg, IL 60173
P: 847.756.4180
www.rtmec.com

rtm
engineering consultants
650 E. Algonquin Road | Suite 250 | Schaumburg, IL 60173
T: 847.756.4180 F: 847.756.4180 www.rtmec.com

SIGNATURE _____
DATE: 6/28/2021

REVISIONS

NO.	DESCRIPTION	DATE
1	ISSUED FOR BID	06/28/21
2	ADDENDUM #3	07.27.21

PROJECT NUMBER 220122.00
DATE OF ISSUE 06.28.21
DRAWN BY MB/BD
CHECKED BY DP

**FIRST FLOOR
HYDRONIC &
CONTROLS
DEMOLITION PLAN**

MD201
ISSUED FOR BID

MECHANICAL GENERAL NOTES

1. REFER TO M-000 FOR MECHANICAL NOTES & M-001 FOR MECHANICAL SCHEDULES.
2. REFER TO ARCHITECTURAL ELEVATIONS FOR EXACT LOUVER LOCATIONS.
3. COORDINATE LOUVER MOUNTING REQUIREMENTS WITH SPECIFIC WALL TYPES.
4. PROVIDE DRIP PAN BELOW ALL HORIZONTAL RUNS FOR VENTS/COMBUSTION. TO BE DRAINED TO FLOOR DRAIN.
5. PROVIDE LINED ELBOW OFF ALL RETURNS FOR PLENUM RETURN SYSTEM.
6. CEILINGS ARE USED FOR PLENUM RETURN. PVC SHOULD NOT BE USED ABOVE CEILINGS AND ALL CABLING SHOULD BE PLENUM RATED.

MECHANICAL KEY NOTES

- (1) PROVIDE SPACE WITH SUICIDE DETERRENT SUPPLY/RETURN GRILLES.
- (2) NEW 24"x20" EXHAUST DUCT TO CONNECT TO EXISTING EXHAUST RISER.
- (3) PROVIDE NEW VENT CAP FOR DRYER EXHAUST.
- (4) PROVIDE NEW DRYER VENT CONNECTION TO DRYER. COORDINATE EXACT LOCATION IN FIELD.
- (5) 12"x10" EXHAUST UP THROUGH EXISTING CHASE TO NEW ROOF CAP. SEE ROOF PLAN FOR MORE INFORMATION.
- (6) TRANSFER DUCT ABOVE CEILING TO ALLOW FOR CLEAR AIR PATH BACK TO AIR HANDLING UNIT.
- (7) 18"x4" RETURN DUCT UP TO LEVEL 2 THROUGH EXISTING FLOOR PENETRATION. VERTICAL DUCT SHALL TAP INTO 54"x30" HORIZONTAL DUCT WITHIN THE MECHANICAL ROOM. PROVIDE MITERED TRANSITION ELBOW WITH TURNING VANES. ELBOW SHALL TRANSITION TO 80"x30" ALL HORIZONTAL RETURN DUCT SHALL BE INTERNALLY LINED. PROVIDE FIRE DAMPERS AT DUCT PENETRATION OF MECHANICAL ROOM WALL.
- (8) PROVIDE SECURITY BARS IN DUCTWORK AT WALL.
- (9) VAV BOX AND ALL ASSOCIATED DUCTWORK, PIPING, AND ELECTRICAL TO BE PART OF ALTERNATE 1 AND ALTERNATE 2 SCOPES.
- (10) IN DISPATCH ROOM DURING PHASE 1 PROVIDE TEMPORARY AC MATCHING SIZE OF EXISTING UNIT.

PLENUM NOTES

THE SPACE ABOVE THE CEILING IS BEING UTILIZED AS A RETURN AIR PLENUM. ALL PIPING, WIRING AND DEVICES INSTALLED WITHIN THE PLENUM SHALL BE UL LISTED PLENUM RATED AND COMPLY WITH CURRENT AND LOCAL CODES. EXPOSED MATERIAL WITHIN THE PLENUM SHALL BE NONCOMBUSTIBLE OR SHALL HAVE A FLAME SPREAD INDEX OF NOT MORE THAN 25 AND A SMOKE DEVELOPMENT INDEX OF NOT MORE THAN 50 WHEN TESTED IN ACCORDANCE WITH ASTM E 84.

LEGAT ARCHITECTS
DESIGN | PERFORMANCE | SUSTAINABILITY

JOLIET
JUNIOR
COLLEGE

CAMPUS POLICE
RENOVATIONS

1215 Houbolt Road
Joliet, IL 60431

ARCHITECT

Legat Architects

2015 Spring Road, Suite 175
Oak Brook, IL, 60523
P: 630.990.3541
www.legat.com

CIVIL ENGINEER

RT&A Inc.

129 Capita Drive
Shorewood, IL 60404
P: 815.744.5600
www.ruettigertonnelli.com

STRUCTURAL ENGINEER

Pease Borst & Associates

18 Executive Court
South Barrington, IL 60010
P: 847.842.6930
F: 847.842.6935
www.peaseborst.com

MEP/FP ENGINEER

RTM Engineering
Consultants

650 E. Algonquin, Suite 250
Schaumburg, IL 60173
P: 847.756.4180
www.rtmec.com



SIGNATURE
DATE: 5/25/2021

REVISIONS


NO.	DESCRIPTION	DATE
	ISSUED FOR BID	06/28/21
Δ	ADDENDUM #3	07.27.21


PROJECT NUMBER 220122.00
DATE OF ISSUE 06.28.21
DRAWN BY MB/BD
CHECKED BY DP

FIRST FLOOR
MECHANICAL PLAN

M-101
ISSUED FOR BID

1 FIRST FLOOR MECHANICAL PLAN
M-101 SCALE: 1/8" = 1'-0"

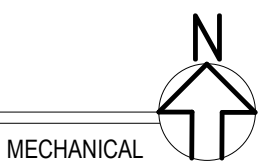

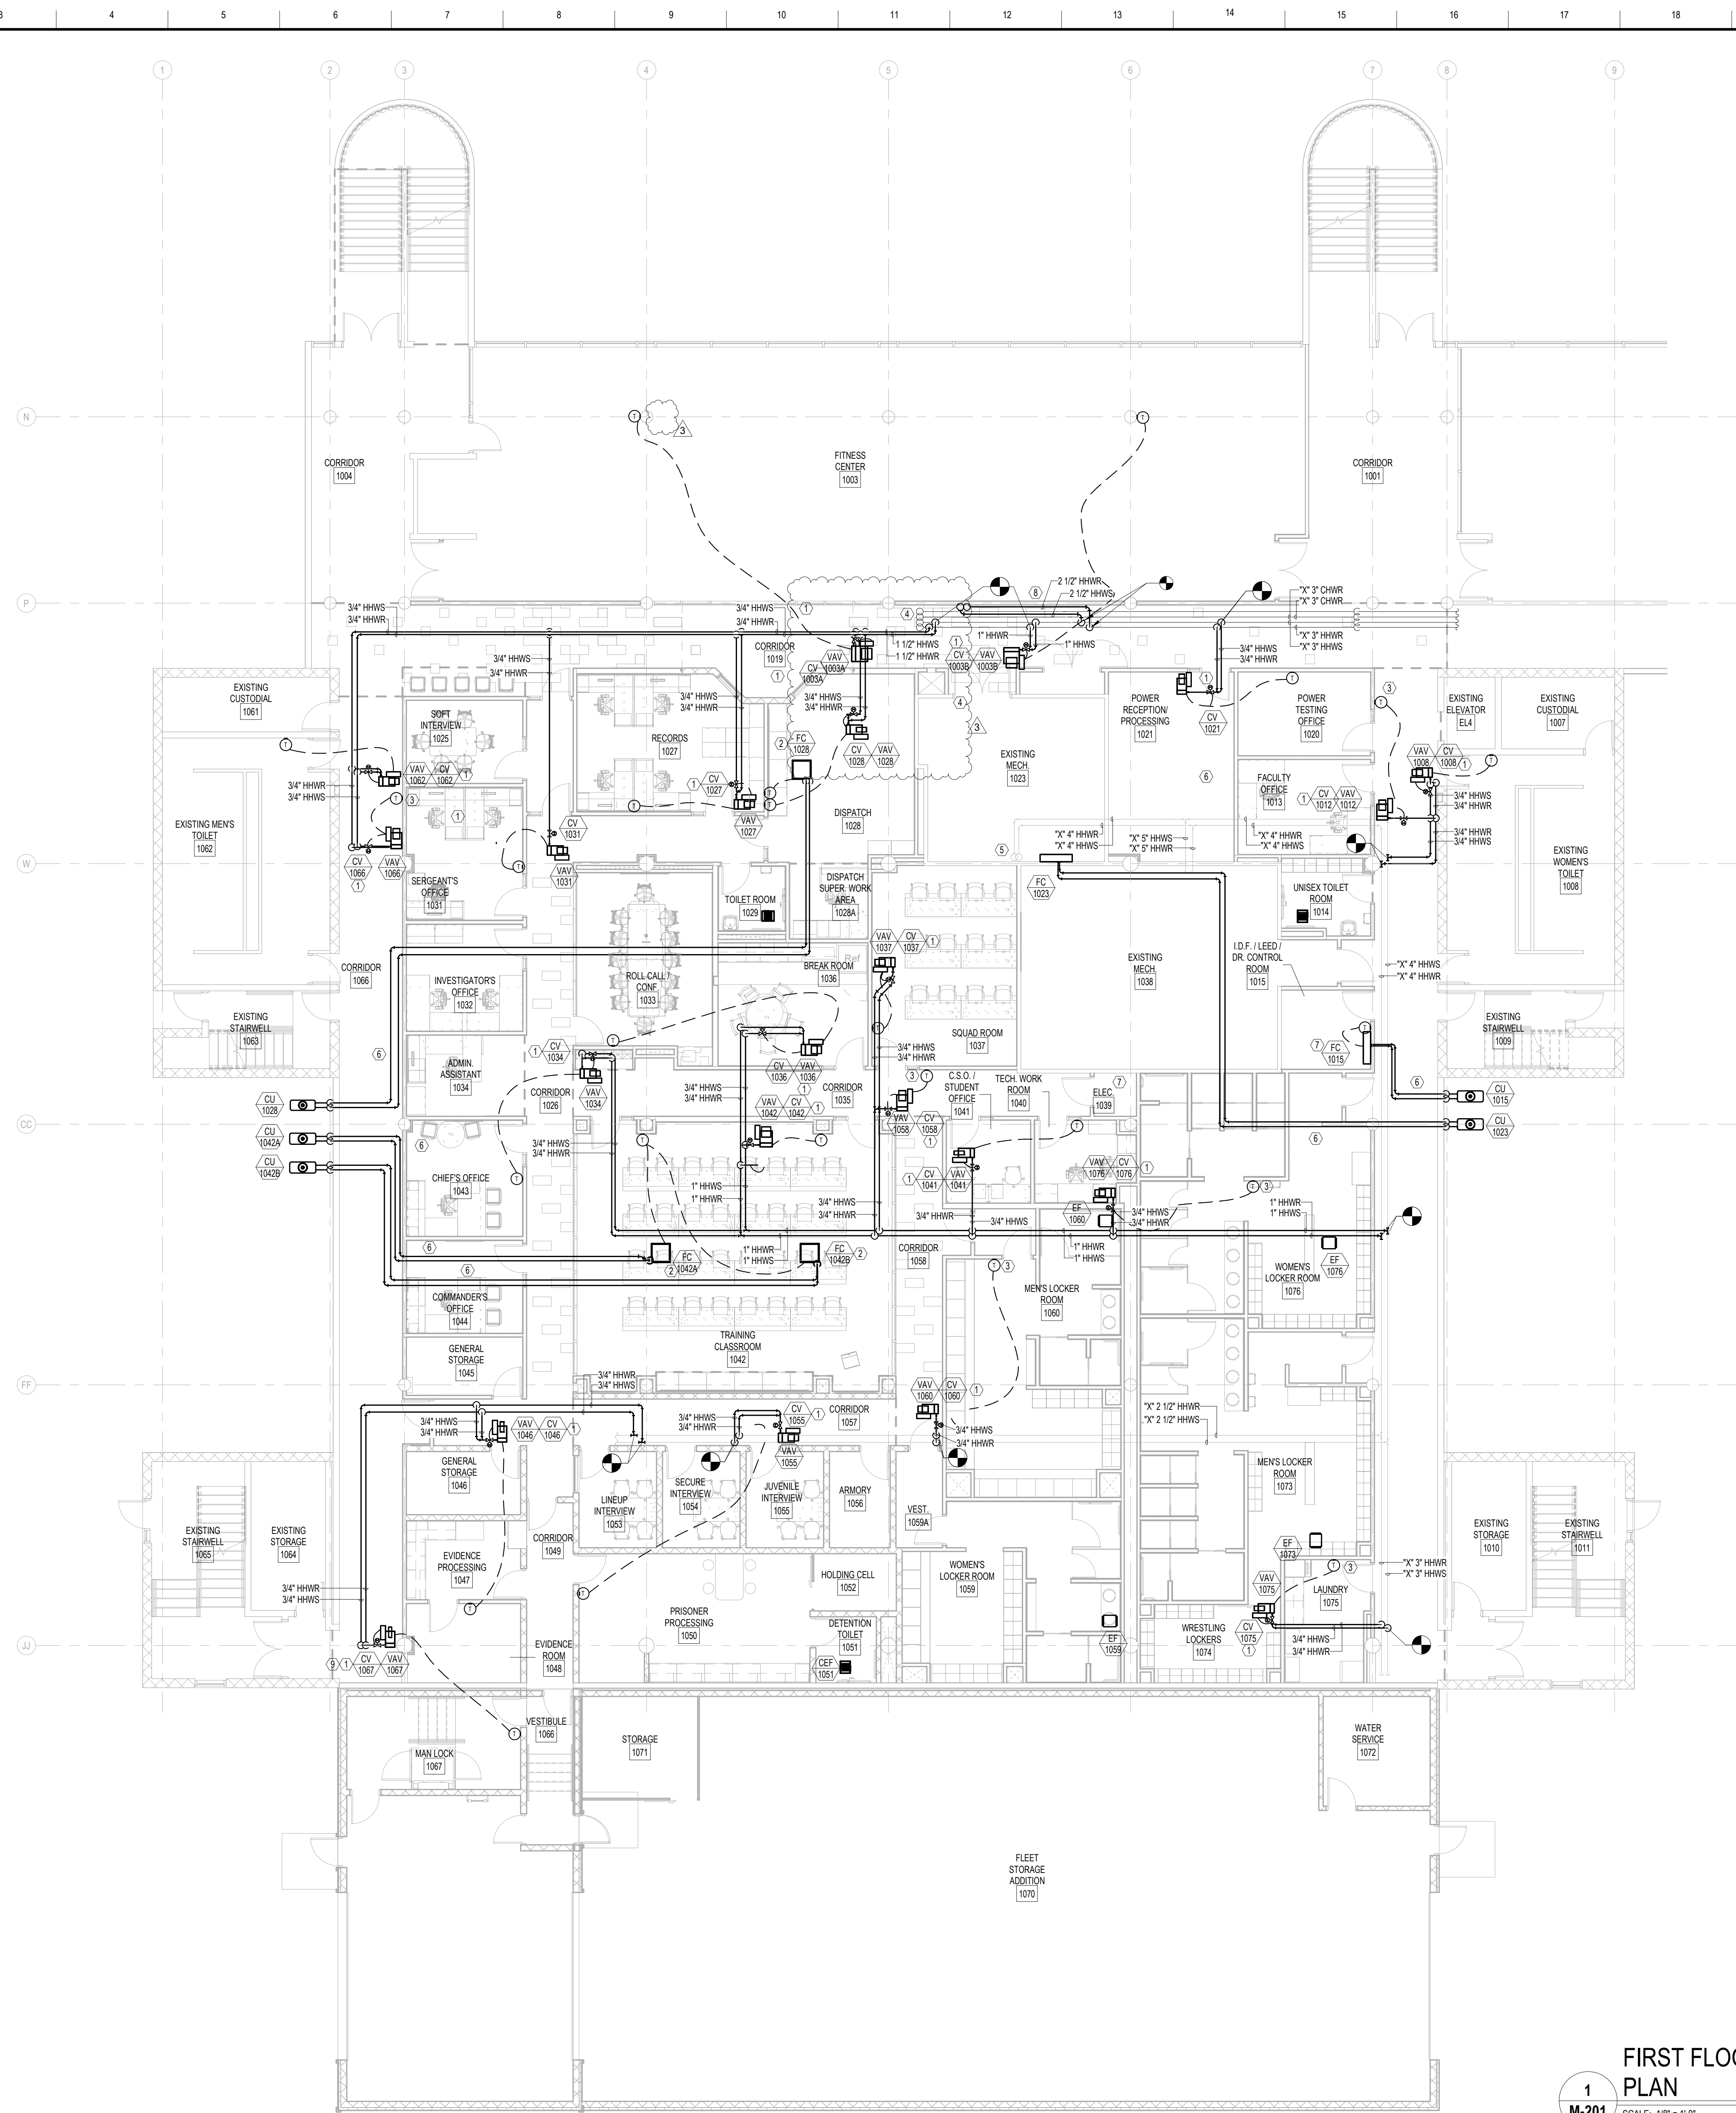

MECHANICAL GENERAL NOTES

1. REFER TO M-000 FOR MECHANICAL NOTES & M-001 FOR MECHANICAL SCHEDULES.
 2. REFER TO ARCHITECTURAL ELEVATIONS FOR EXACT LOUVER LOCATIONS.
 3. COORDINATE LOUVER MOUNTING REQUIREMENTS WITH SPECIFIC WALL TYPES.
 4. PROVIDE DRIP PAN BELOW ALL HORIZONTAL RUNS FOR VENTS/COMBUSTION TO BE DRAINED TO FLOOR DRAIN.
 5. PROVIDE DRIP PANS WITH LEAK DETECTION/ALARM FOR ALL HYDRONIC AND REFRIGERANT PIPING THAT RUNS OVER IDF OR ELECTRICAL ROOMS.
- ### MECHANICAL KEY NOTES
1. CONTROL VALVE TO BE CONNECTED TO CORRESPONDING VAV BOX FOR CONTROL AND COMMUNICATION.
 2. FAN COILS TO ONLY OPERATE DURING EMERGENCY SITUATION.
 3. THERMOSTAT LOCATED IN PUBLIC SPACE TO BE PROVIDED WITH LOCKABLE COVER.
 4. EXISTING HHWS, HHWR, CHWS, AND CHWR RISER TO REMAIN.
 5. EXISTING HHWS, AND HHWR RISER TO REMAIN.
 6. NEW REFRIGERANT LIQUID AND SUCTION LINES FROM CU TO FC UNITS. COORDINATE EXACT SIZE WITH MANUFACTURER.
 7. ROUTE EXISTING/NEW HYDRONIC PIPING AROUND IT/ELECTRICAL CLOSETS AS NECESSARY.
 8. CONNECT NEW 2-1/2" HWS/R PIPING TO EXISTING 3" MAIN. ROUTE UP THROUGH SECOND FLOOR TO 2ND FLOOR MECHANICAL ROOM. CONTRACTOR TO COORDINATE WITH EXISTING CONCRETE REINFORCEMENT TO AVOID CUTTING STEEL.
 9. VAV BOX AND ALL ASSOCIATED DUCTWORK, PIPING, AND ELECTRICAL TO BE PART OF ALTERNATE 1 AND ALTERNATE 2 SCOPES.

LEGAT ARCHITECTS
DESIGN | PERFORMANCE | SUSTAINABILITY

JOLIET JUNIOR COLLEGE

CAMPUS POLICE RENOVATIONS

1215 Houbolt Road
Joliet, IL 60431

ARCHITECT
Legat Architects

2015 Spring Road, Suite 175
Oak Brook, IL, 60523
P: 630.990.3541
www.legat.com

CIVIL ENGINEER

RT&A Inc.

129 Capita Drive
Shorewood, IL 60404
P: 815.744.5600
www.ruettigertonnelli.com

STRUCTURAL ENGINEER

Pease Borst & Associates

18 Executive Court
South Barrington, IL 60010
P: 847.842.6930
F: 847.842.6935
www.peaseborst.com

M/E/P ENGINEER

RTM Engineering
Consultants

650 E. Algonquin, Suite 250
Schaumburg, IL 60173
P: 847.756.4180
www.rtmec.com

rtm
engineering consultants
650 E. Algonquin Road | Suite 250 | Schaumburg, IL 60173
P: 847.756.4180 | F: 847.756.4188 | www.rtmec.com

SIGNATURE
DATE: 8/25/2021

REVISIONS		
NO.	DESCRIPTION	DATE
1	ISSUED FOR BID	06/28/21
2	ADDENDUM #3	07.27.21


PROJECT NUMBER 220122.00
DATE OF ISSUE 06.28.21
DRAWN BY MB/BD
CHECKED BY DP

FIRST FLOOR HYDRONIC
& CONTROLS PLAN

M-201
ISSUED FOR BID

FIRST FLOOR HYDRONIC & CONTROLS
PLAN

1
M-201
SCALE: 1/8" = 1'-0"

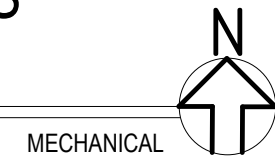




M-301
ISSUED FOR BID

1 2 3 4 5 6 7 8 9 10 11 12 13 14 15 16 17 18 19 20 21 22 23 24 25

A
B
C
D
E
F
G
H
J
K
L
M
N
P
Q
R
S
T
U

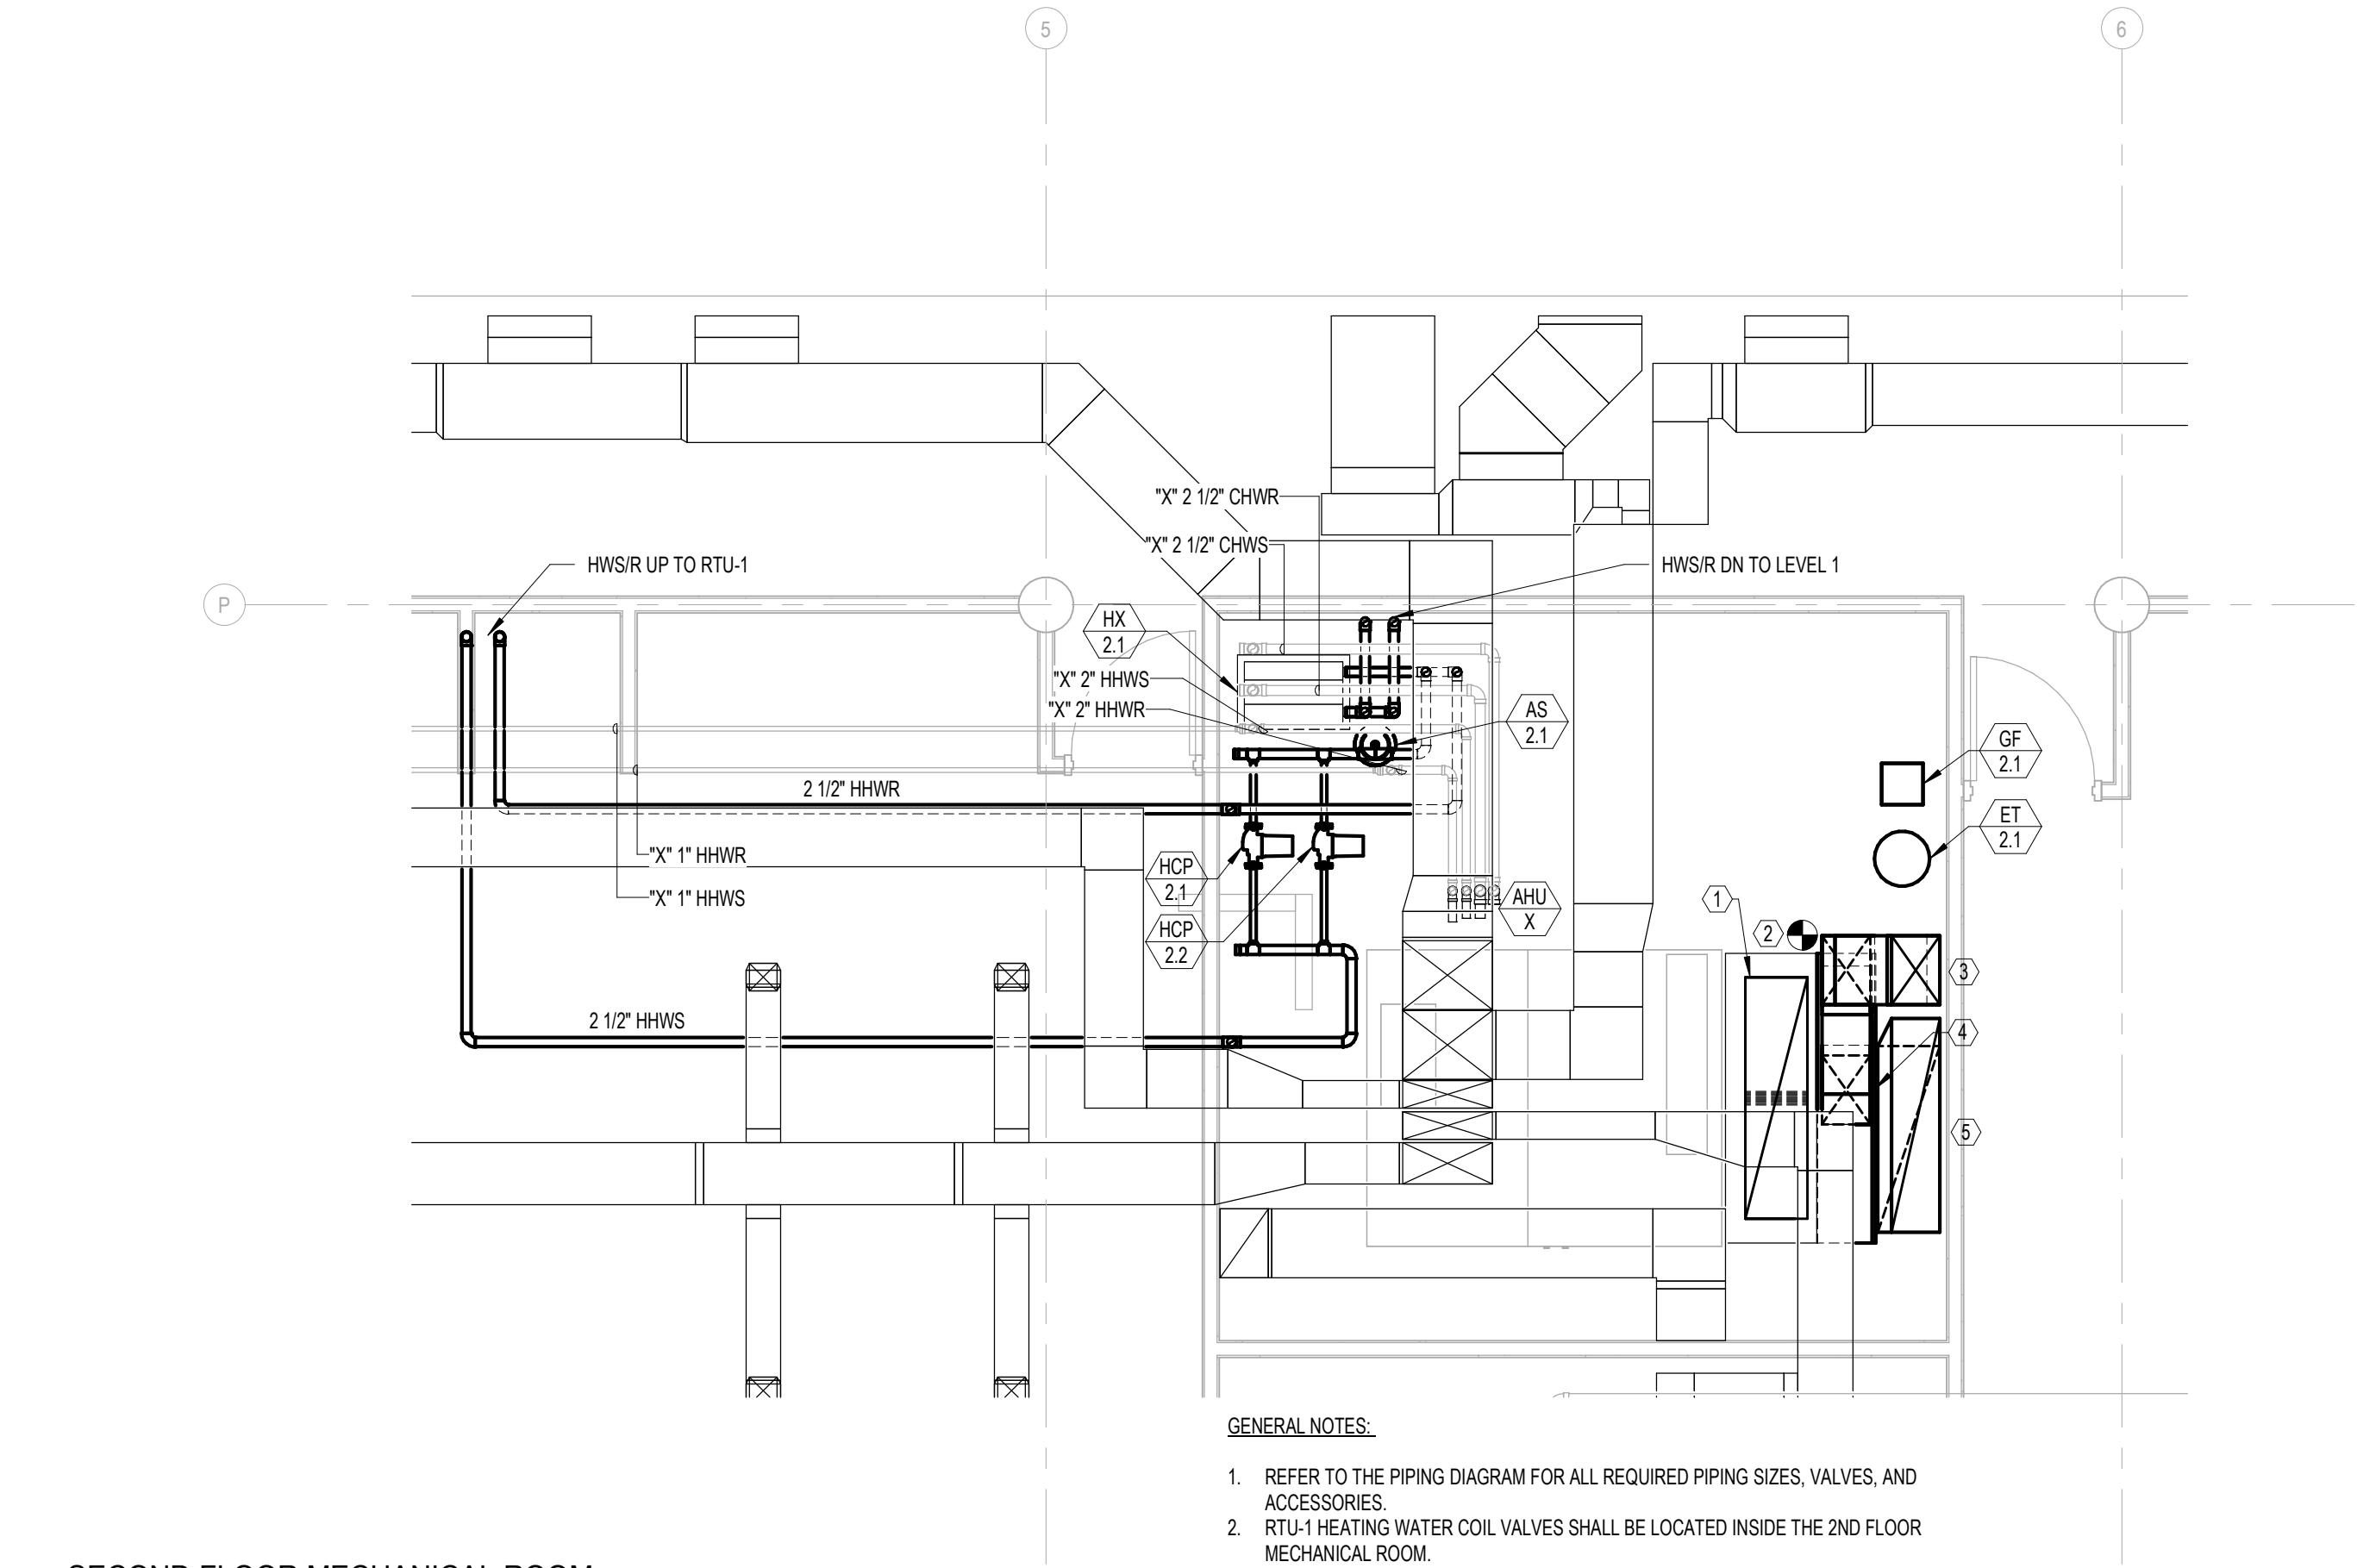


1 SECOND FLOOR MECHANICAL ROOM
ENLARGED PLAN
1/4" = 1'-0"

MECHANICAL KEY NOTES

1. PROVIDE NEW PNEUMATIC CONTROL DAMPER ON THE EXISTING RETURN OPENING. DAMPER SIZE APPROXIMATELY 18X20. CONTRACTOR TO VERIFY SIZE IN FIELD. CONNECT NEW PNEUMATIC TUBING TO EXISTING PANEL IN MECHANICAL ROOM.
2. EXTEND EXISTING OUTSIDE AIR DUCT TO ALLOW FOR NEW CONNECTION. OA DUCT SIZE IS APPROXIMATELY 84X24. CONTRACTOR TO VERIFY SIZE IN FIELD.
3. NEW 14X20 OUTSIDE AIR DUCT UP THROUGH ROOF.
4. CONNECT NEW OUTSIDE AIR DUCT TO INTAKE PLENUM. PROVIDE NEW PNEUMATIC CONTROL DAMPER AND OUTSIDE AIR SENSOR IN DUCT. CONNECT NEW PNEUMATIC TUBING TO EXISTING PANEL IN MECHANICAL ROOM.
5. NEW 14X62 RETURN DUCT THROUGH ROOF. TRANSITION IN VERTICAL TO 18X54 IN ORDER TO ROUTE THROUGH EXISTING 2ND FLOOR PENETRATION.

GENERAL NOTES:

1. REFER TO THE PIPING DIAGRAM FOR ALL REQUIRED PIPING SIZES, VALVES, AND ACCESSORIES.
2. RTU-1 HEATING WATER COIL VALVES SHALL BE LOCATED INSIDE THE 2ND FLOOR MECHANICAL ROOM.

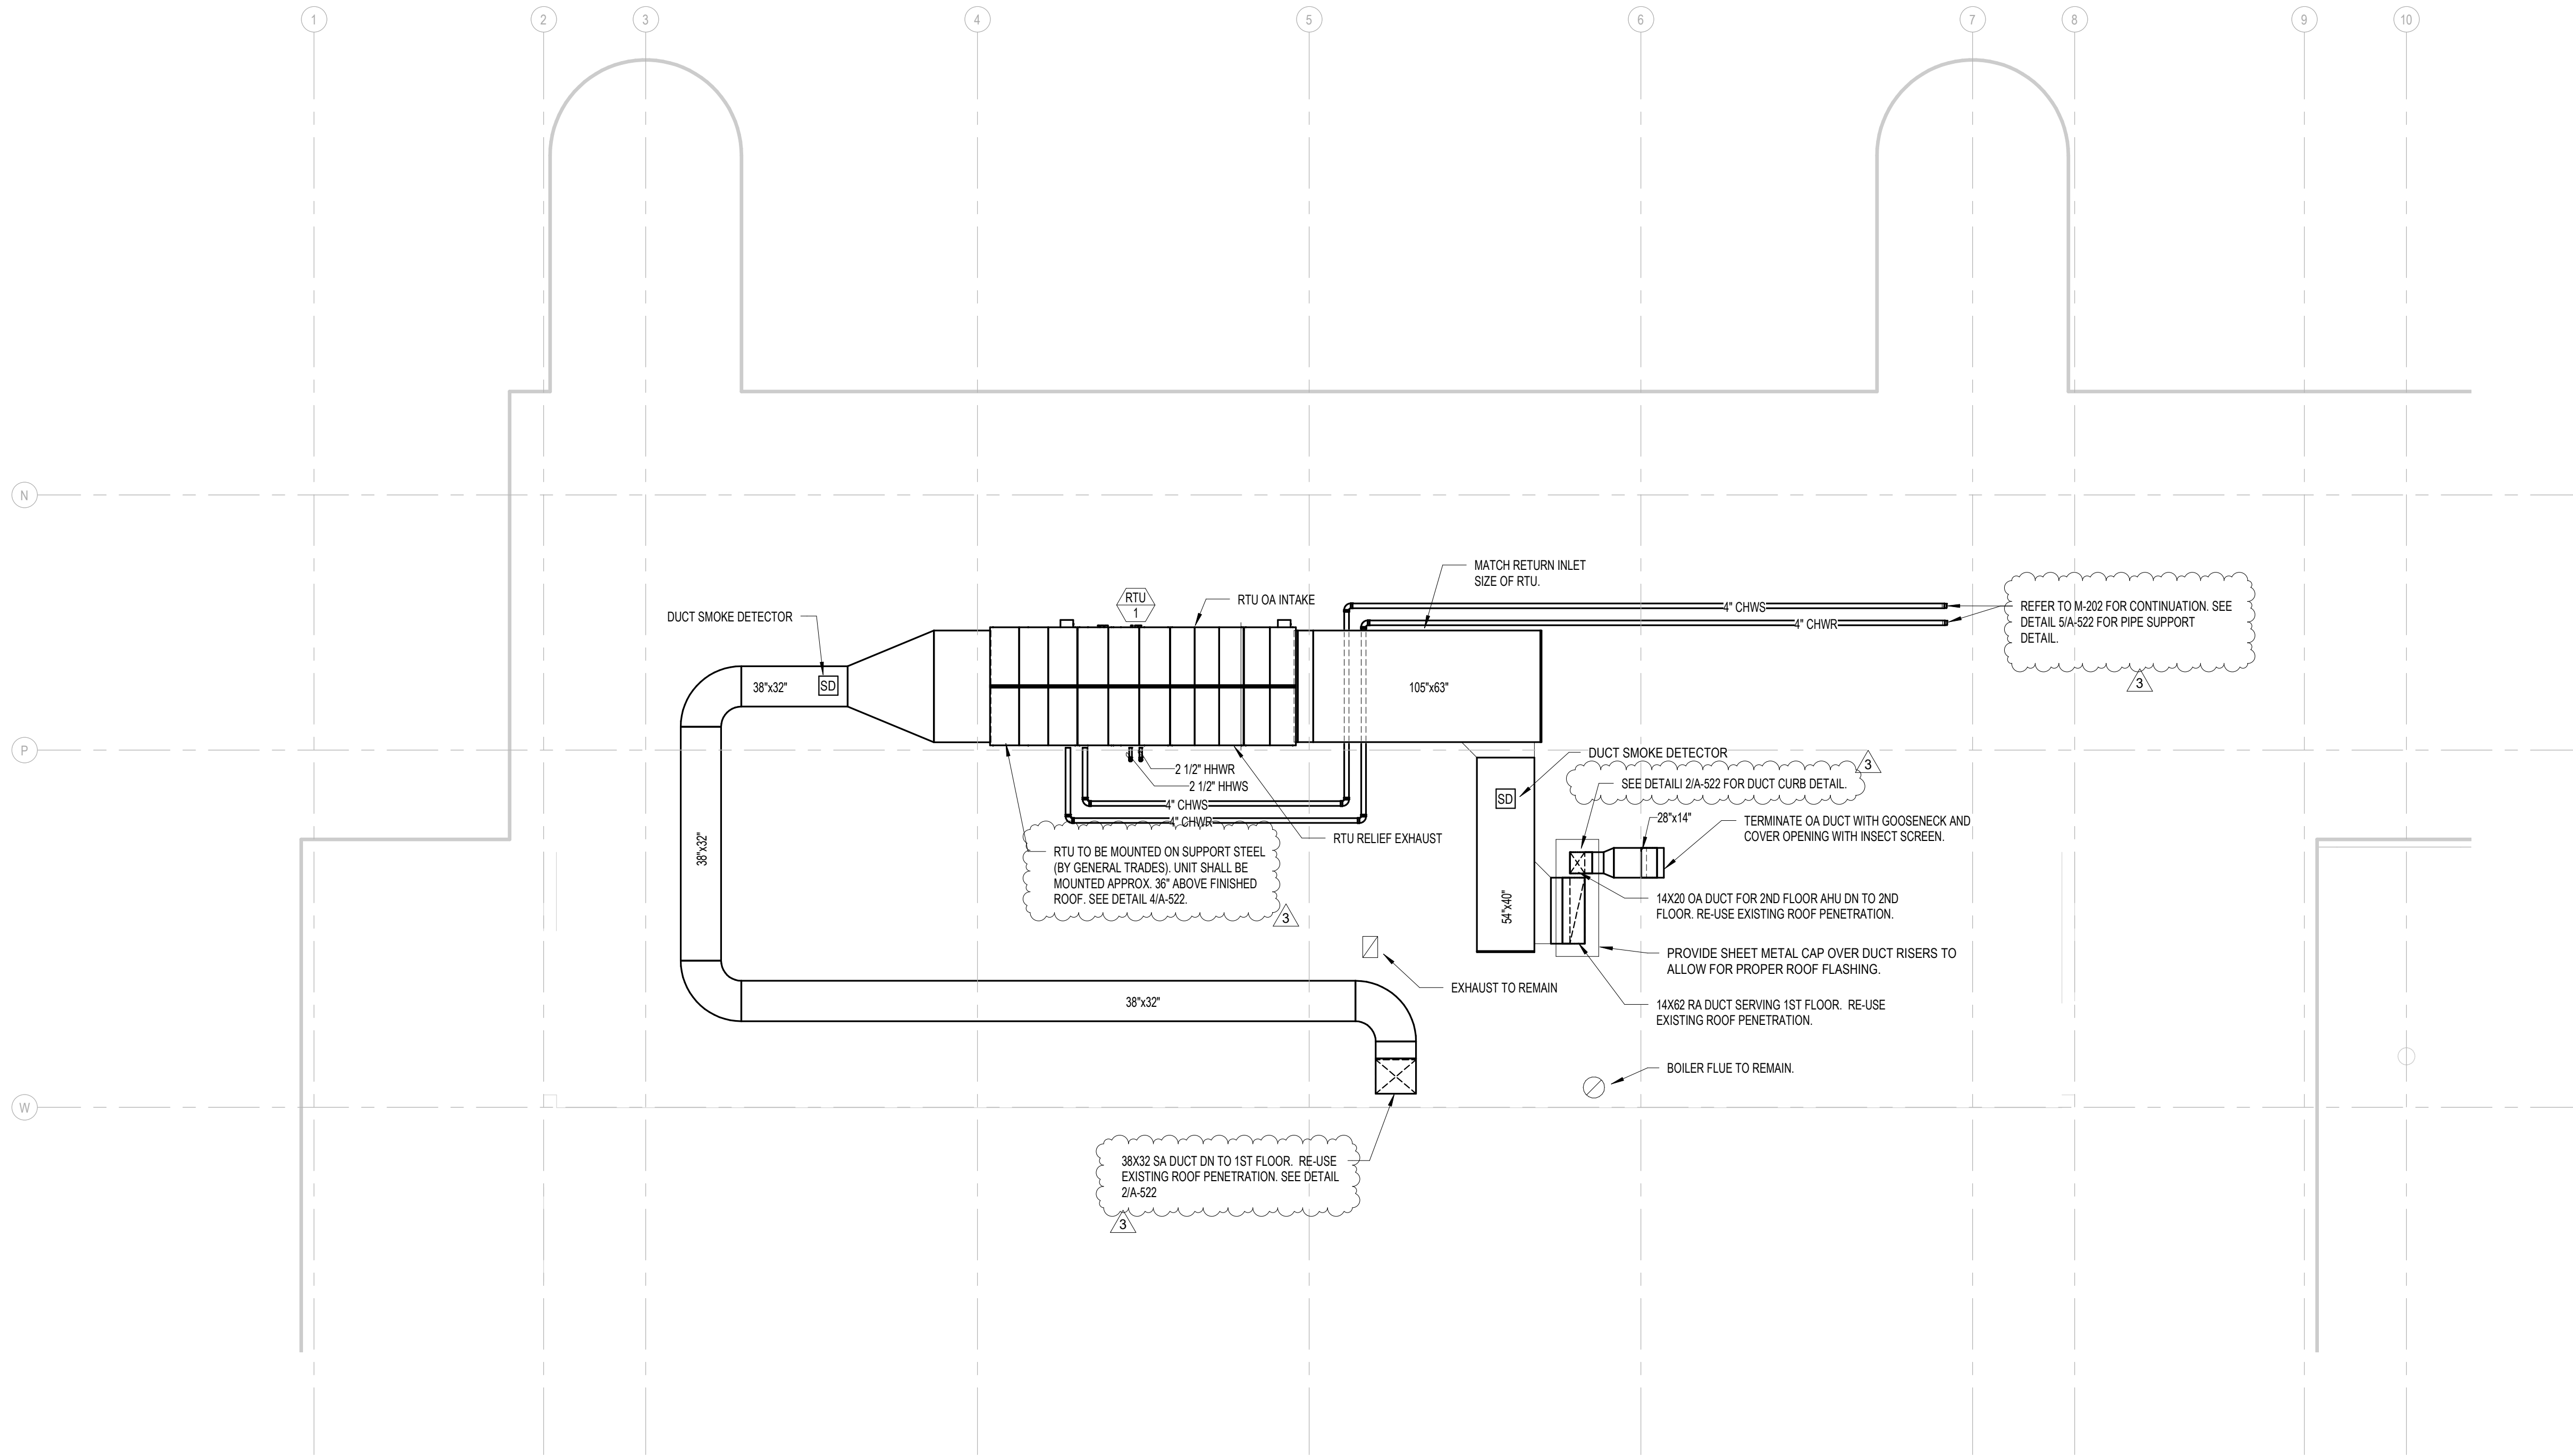

2 MECHANICAL LOW ROOF PLAN
1/8" = 1'-0"

JOLIET
JUNIOR
COLLEGE

CAMPUS POLICE
RENOVATIONS

1215 Houbolt Road
Joliet, IL 60431

ARCHITECT

Legat Architects

2015 Spring Road, Suite 175
Oak Brook IL, 60523
P: 630.990.3541
www.legat.com

CIVIL ENGINEER

RT&A Inc.

129 Capista Drive
Shorewood, IL 60404
P: 815.744.5600
www.ruettigertonnelli.com

STRUCTURAL ENGINEER

Pease Borst & Associates

18 Executive Court
South Barrington, IL 60010
P: 847.842.6930
F: 847.842.6935
www.peaseborst.com

MED/PEP ENGINEER

RTM Engineering
Consultants

650 E. Algonquin, Suite 250
Schaumburg, IL 60173
P: 847.756.4180
www.rtmec.com



SIGNATURE
DATE: 6/25/2021


REVISIONS

NO.	DESCRIPTION	DATE
	ISSUED FOR BID	06/28/21
Δ	ADDENDUM #3	07.27.21

PROJECT NUMBER 220122.00
DATE OF ISSUE 06.28.21
DRAWN BY Author
CHECKED BY Checker

MECHANICAL
ENLARGED PLAN AND
LOW ROOF PLAN


M-302
ISSUED FOR BID

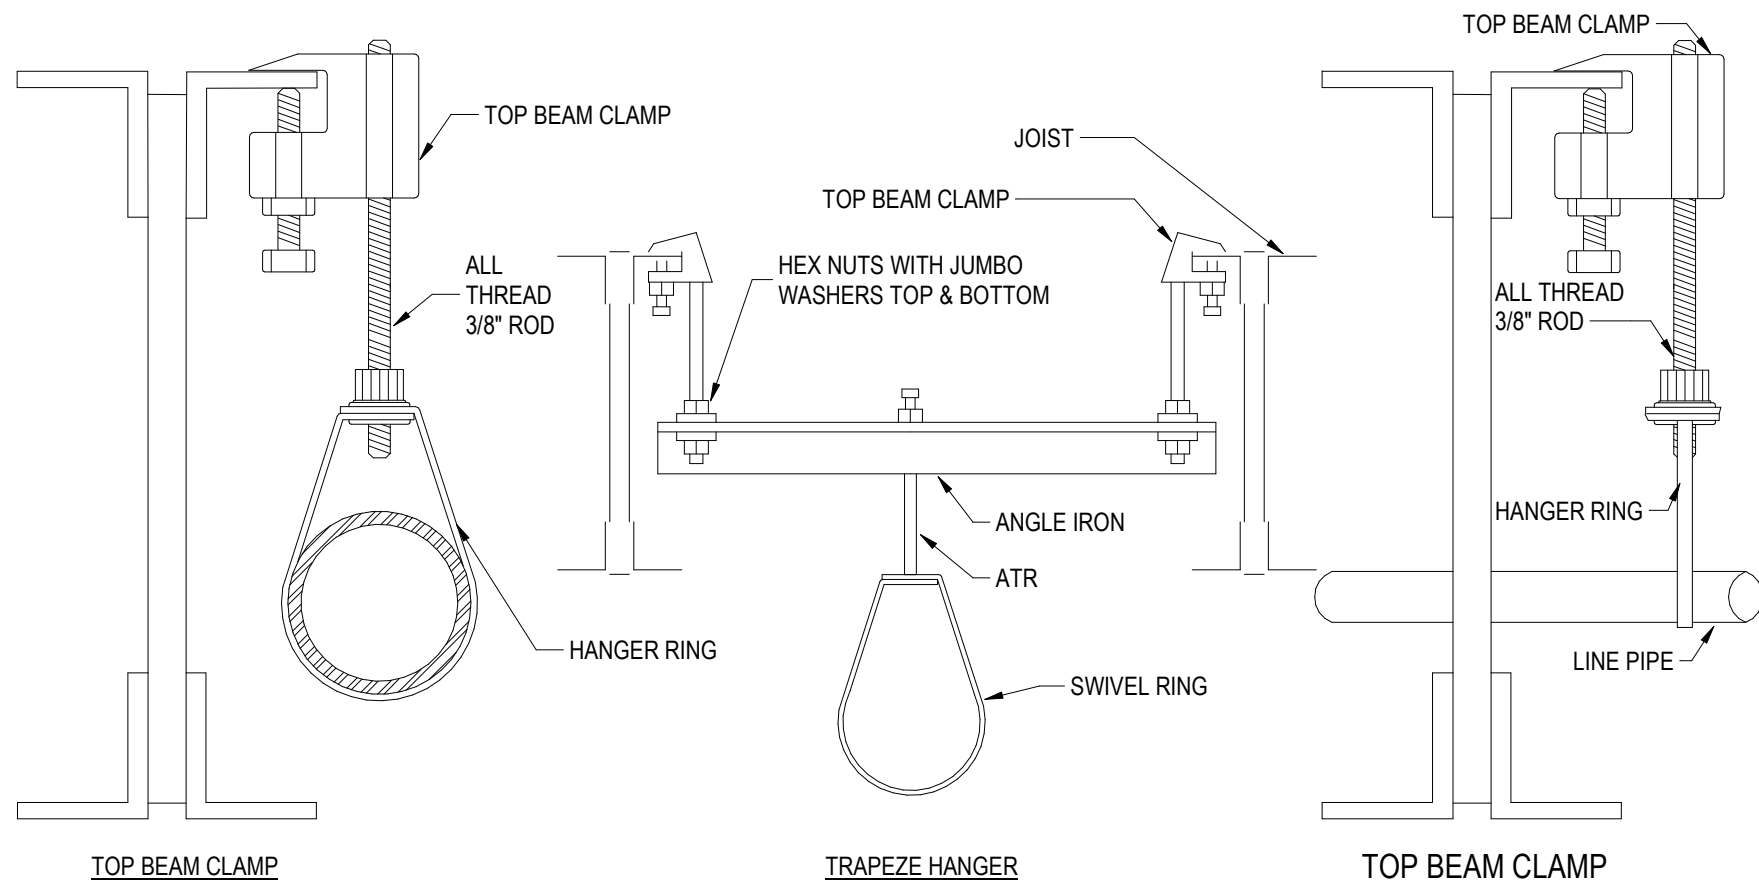

NOTE 1
MINIMUM ROD SIZE SHALL BE 3/8" FOR PIPE 1" AND UP TO 4" IN SIZE & MINIMUM 1/2" FOR PIPE 6" AND LARGER (REFER TO PIPE HANGER DETAILS AND MANUFACTURERS INSTALLATION INSTRUCTION.)


NOTE 2
CUTTING STRUCTURAL MEMBERS TO RUN PIPING OR FACILITATE HANGER FASTENING IS NOT PERMITTED

1
M-402
TYPICAL HANGER DETAILS
NO SCALE MECHANICAL

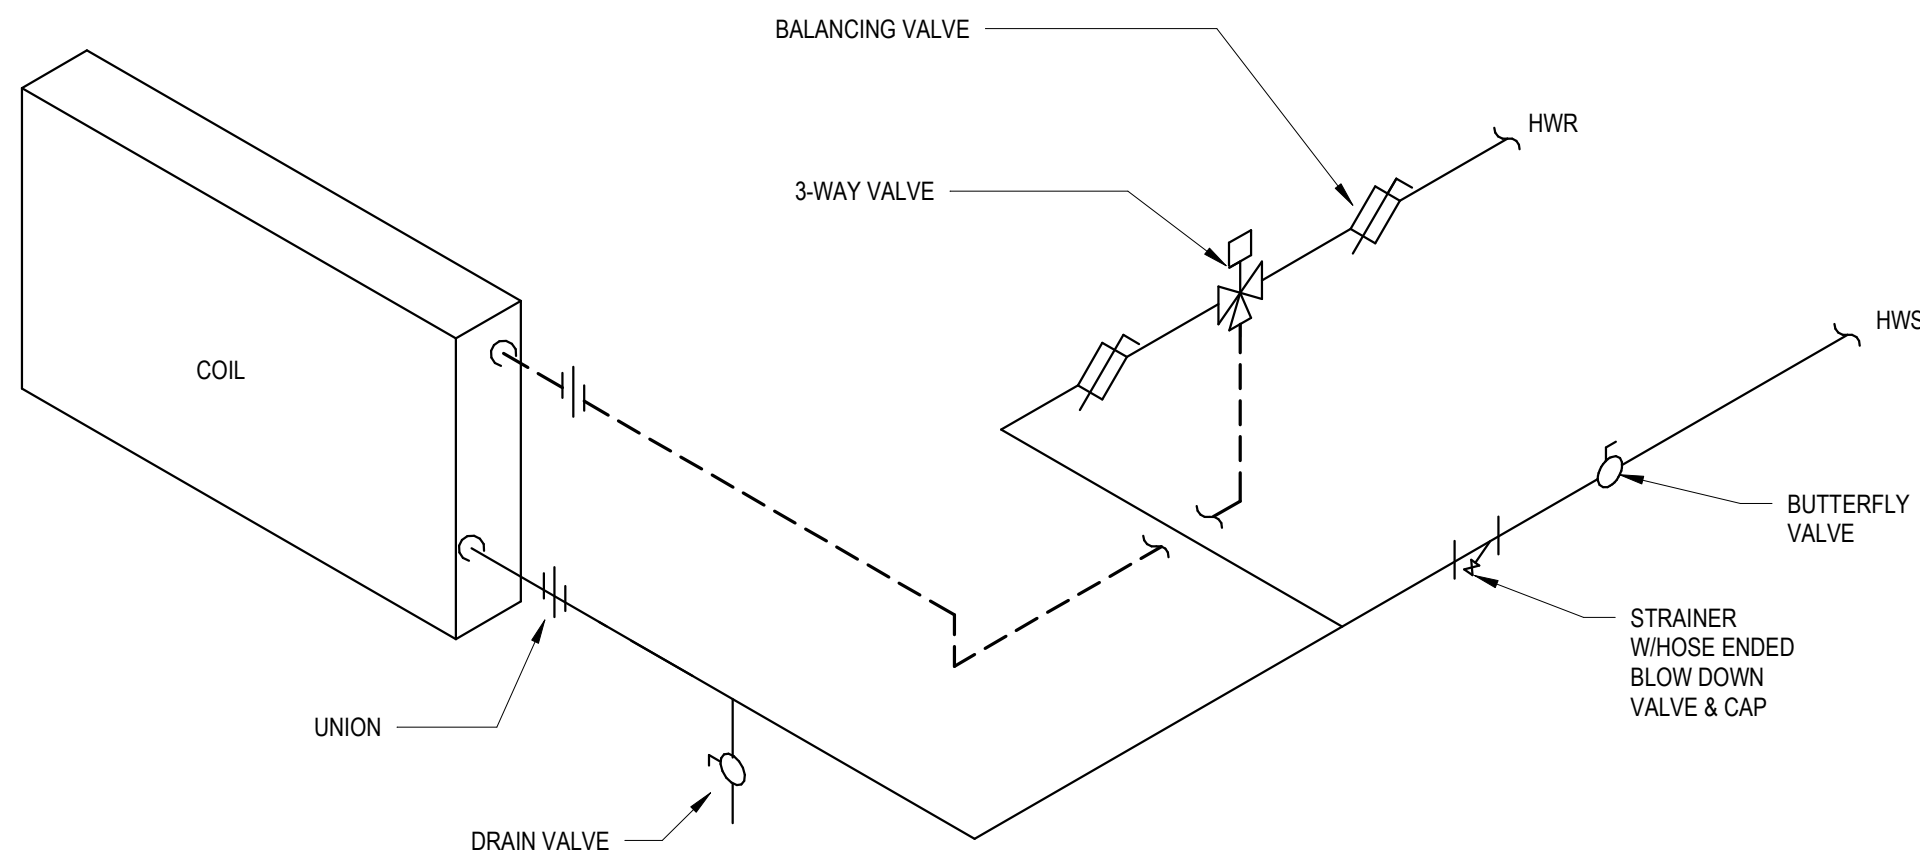


NOTE:
1. LOCATE 3-WAY VALVE WITHIN 2'-0" OF COIL CONNECTION.

2
M-402
AHU HOT WATER REHEAT COIL - THREE WAY VALVE
NO SCALE MECHANICAL

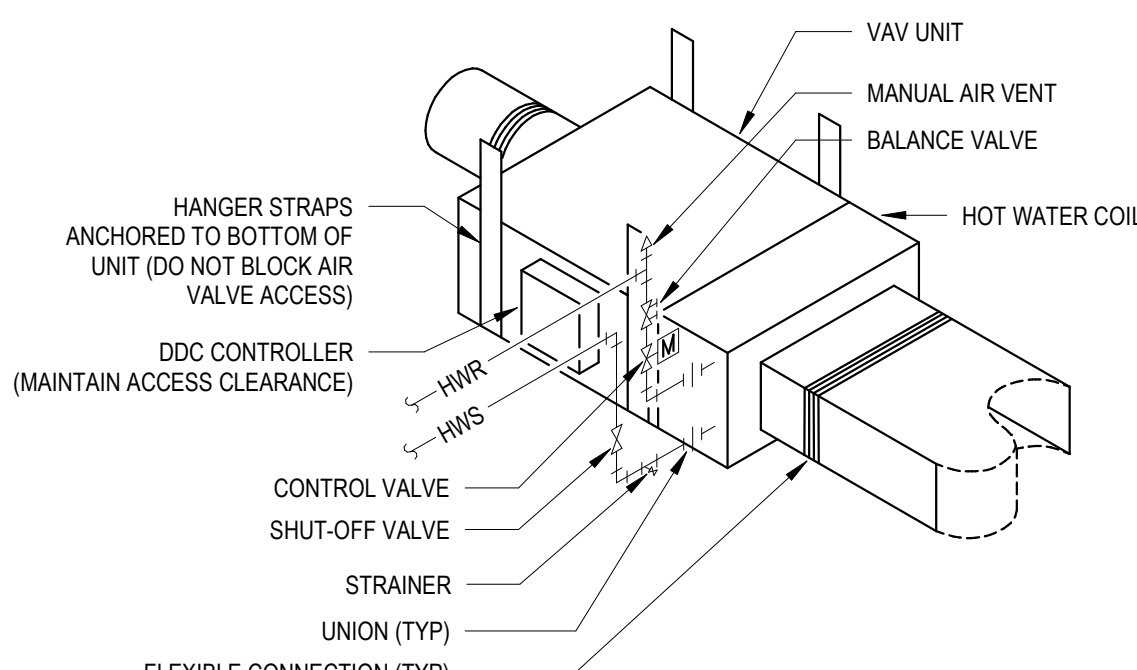


NOTE:
VERIFY CONTROLLER ACCESS ORIENTATION WITH PLAN TO PROVIDE WORKING CLEARANCE


3
M-402
VAV UNIT WITH HOT WATER COIL
NO SCALE MECHANICAL

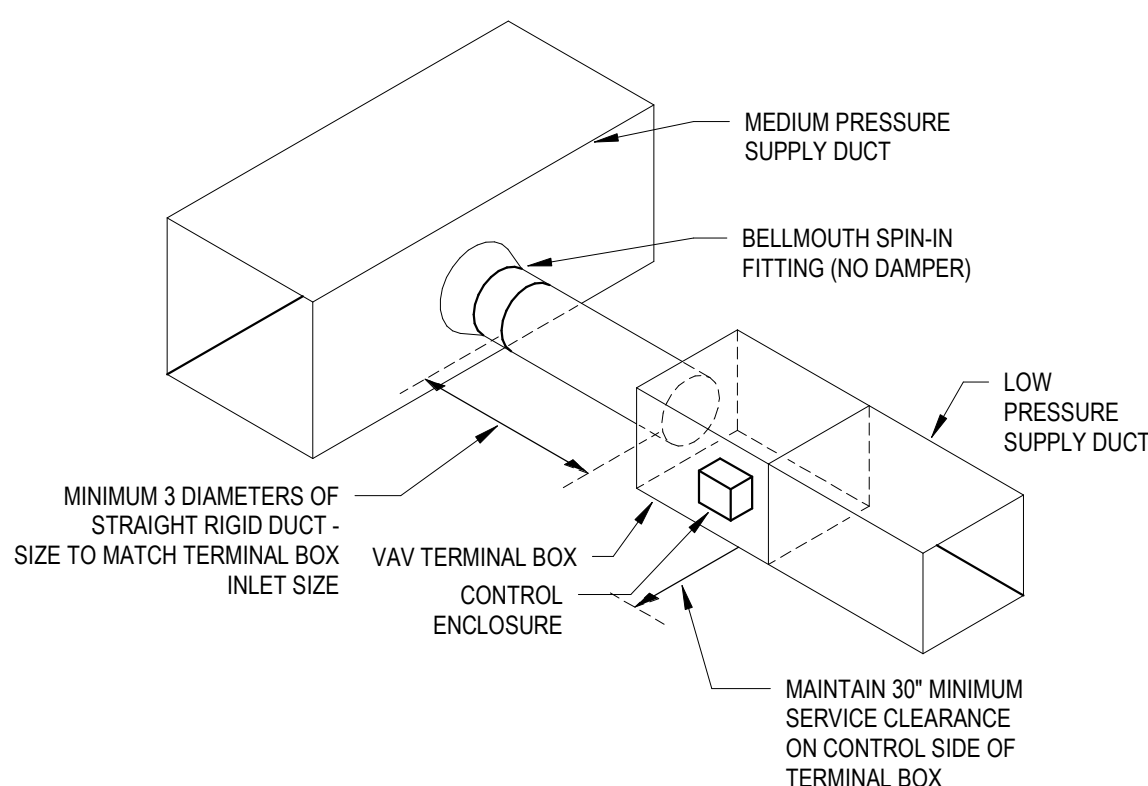

4
M-402
VAV TERMINAL BOX INTALLATION
NO SCALE MECHANICAL

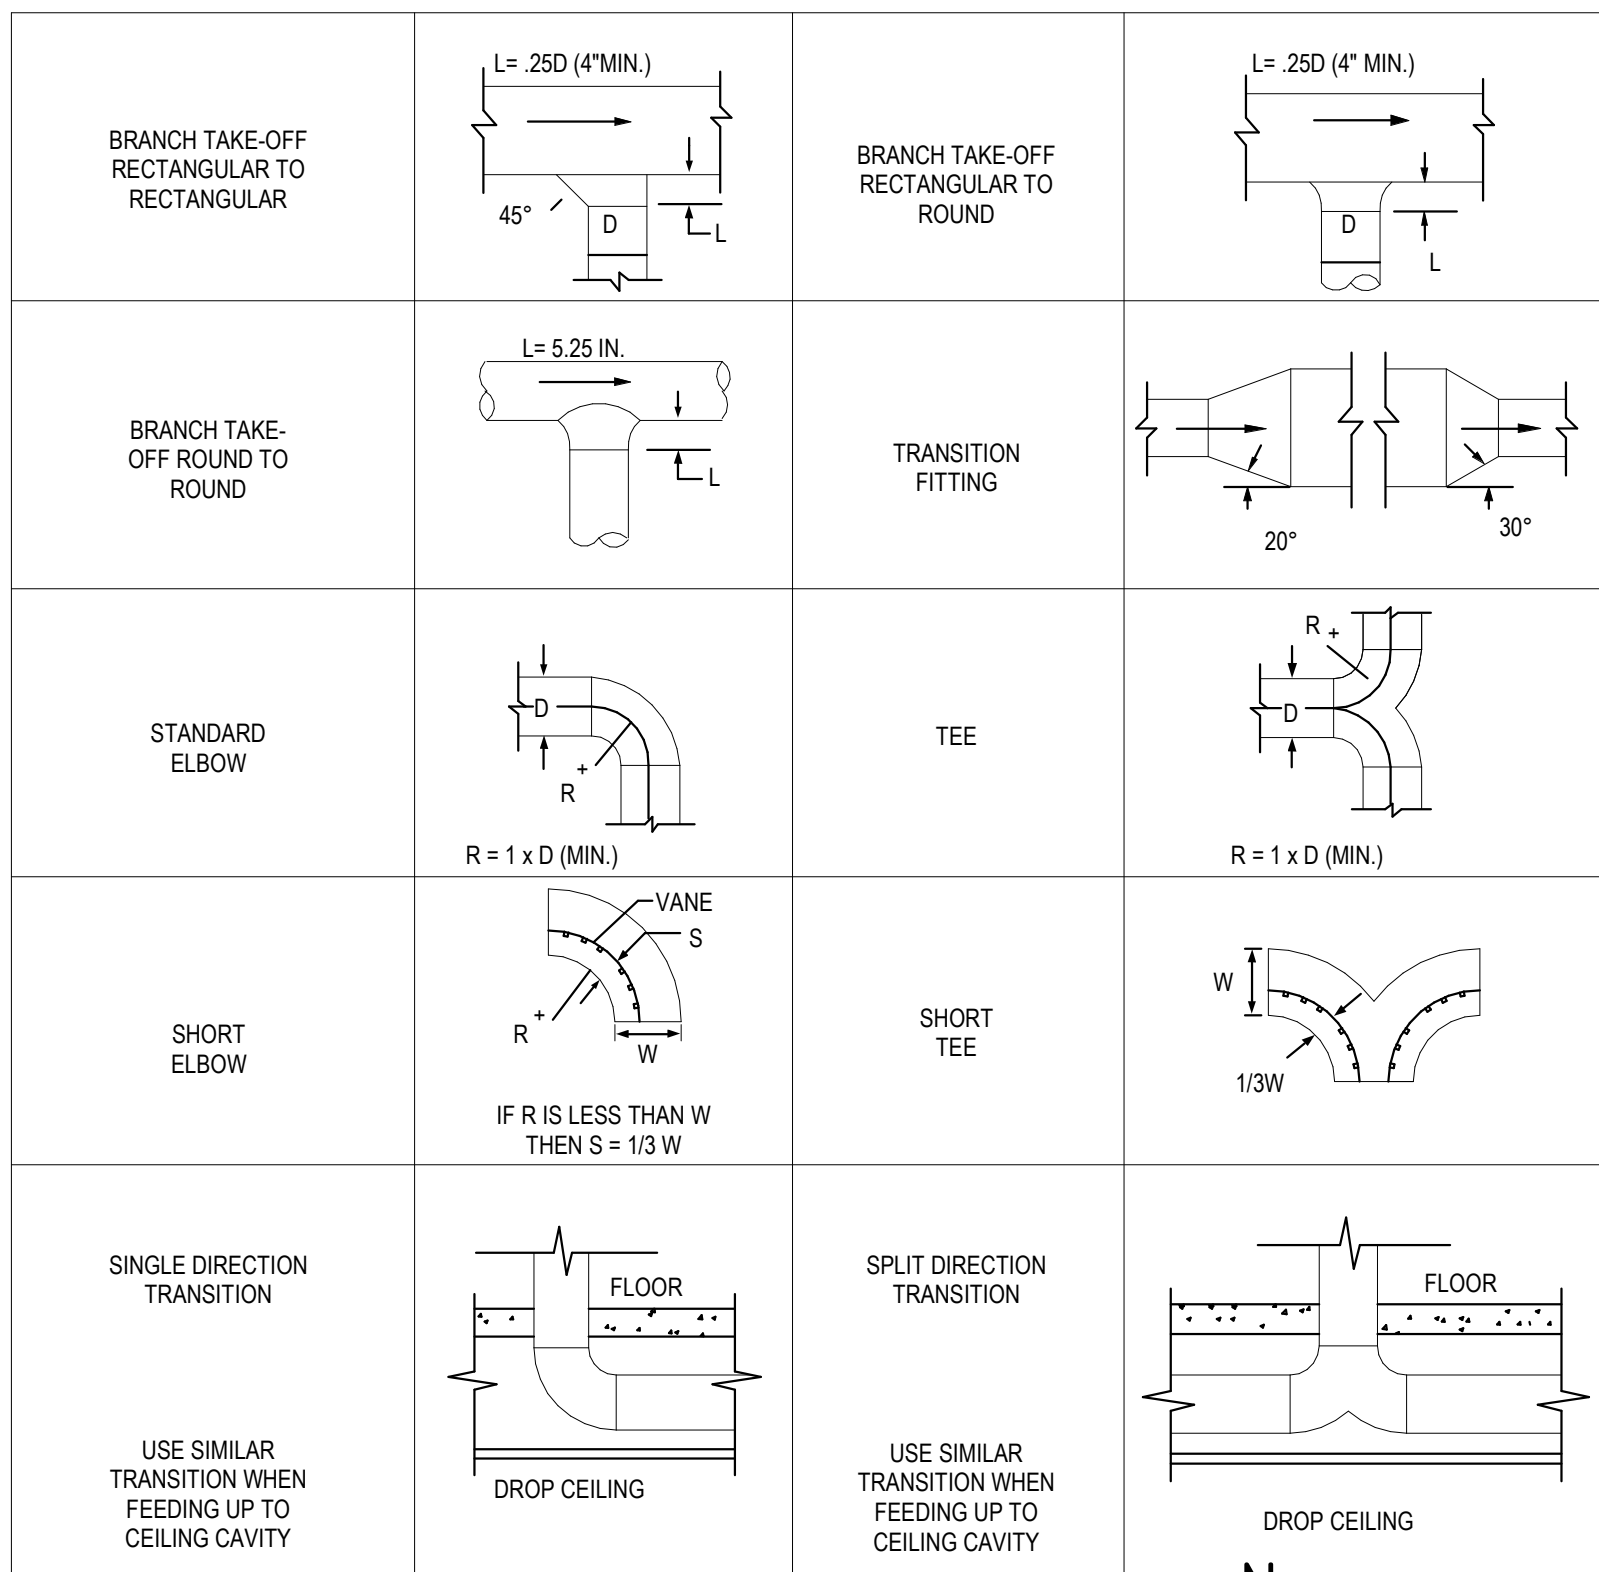

7
M-402
TYPICAL DUCT TAKE-OFFS DETAIL
SCALE: 3" = 1'-0" MECHANICAL

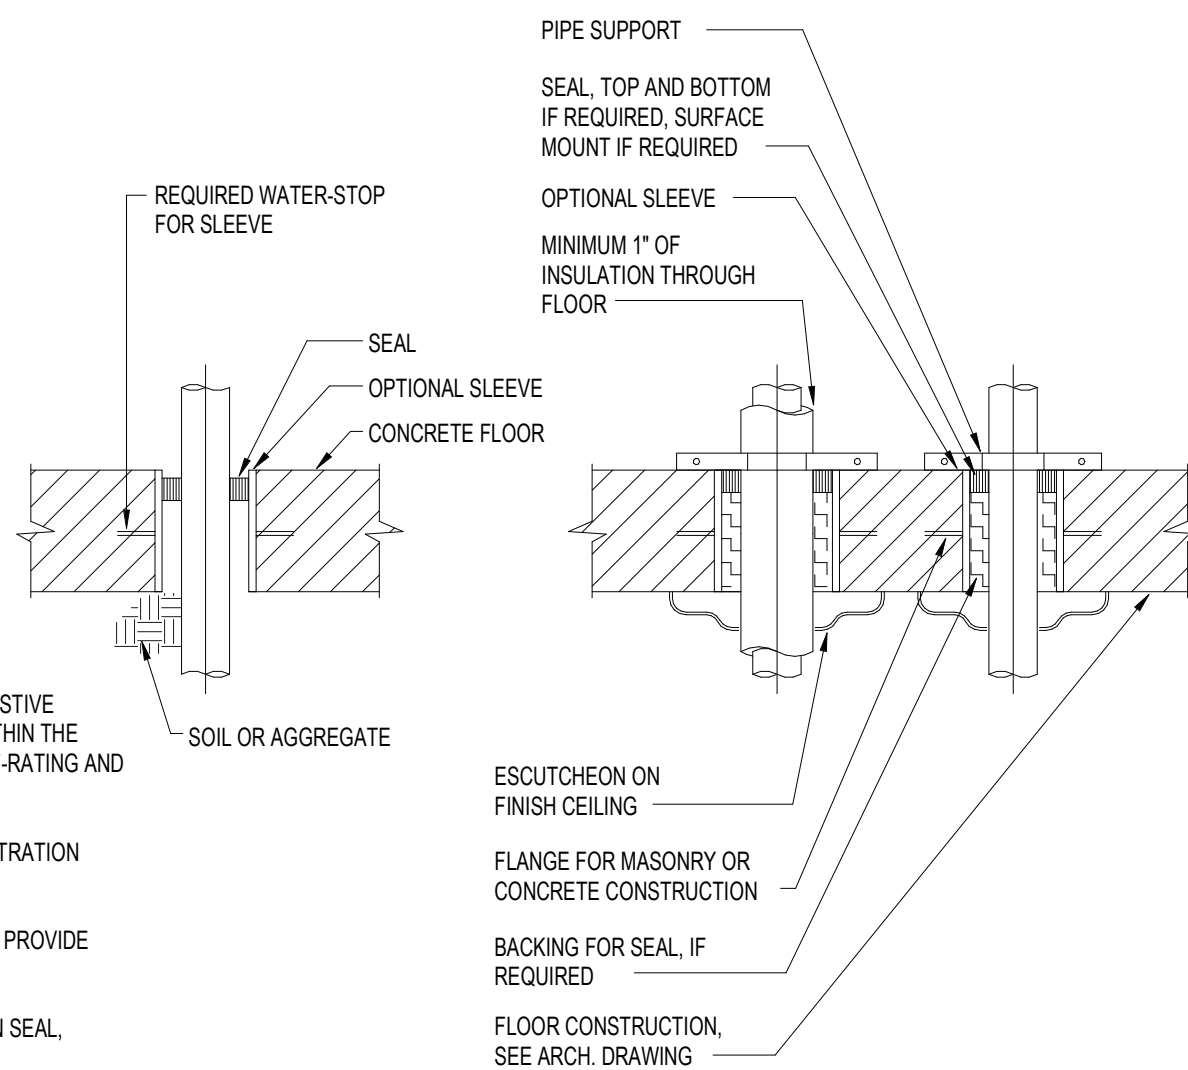


LISTED FIRE STOP SYSTEM SHALL BE ON FIRE-RESISTIVE CONSTRUCTION. INSTALLATION SHALL COMPLY WITHIN THE LIMITATION OF THE LISTING AND MEET REQUIRED F-RATING AND T-RATING.

WATERTIGHT SEAL SHALL BE REQUIRED FOR PENETRATION THROUGH FLOOR AGAINST SOIL OR AGGREGATE.


SMOKE BARRIERS AND ALL OTHER PENETRATIONS, PROVIDE SEAL AS INDICATED IN SPEC.

SEE SPEC. FOR CUTTING, PATCHING, PENETRATION SEAL, SLEEVES, EXCAVATION AND BACKFILLING.


8
M-402
FLOOR PENETRATION DETAIL
NO SCALE MECHANICAL

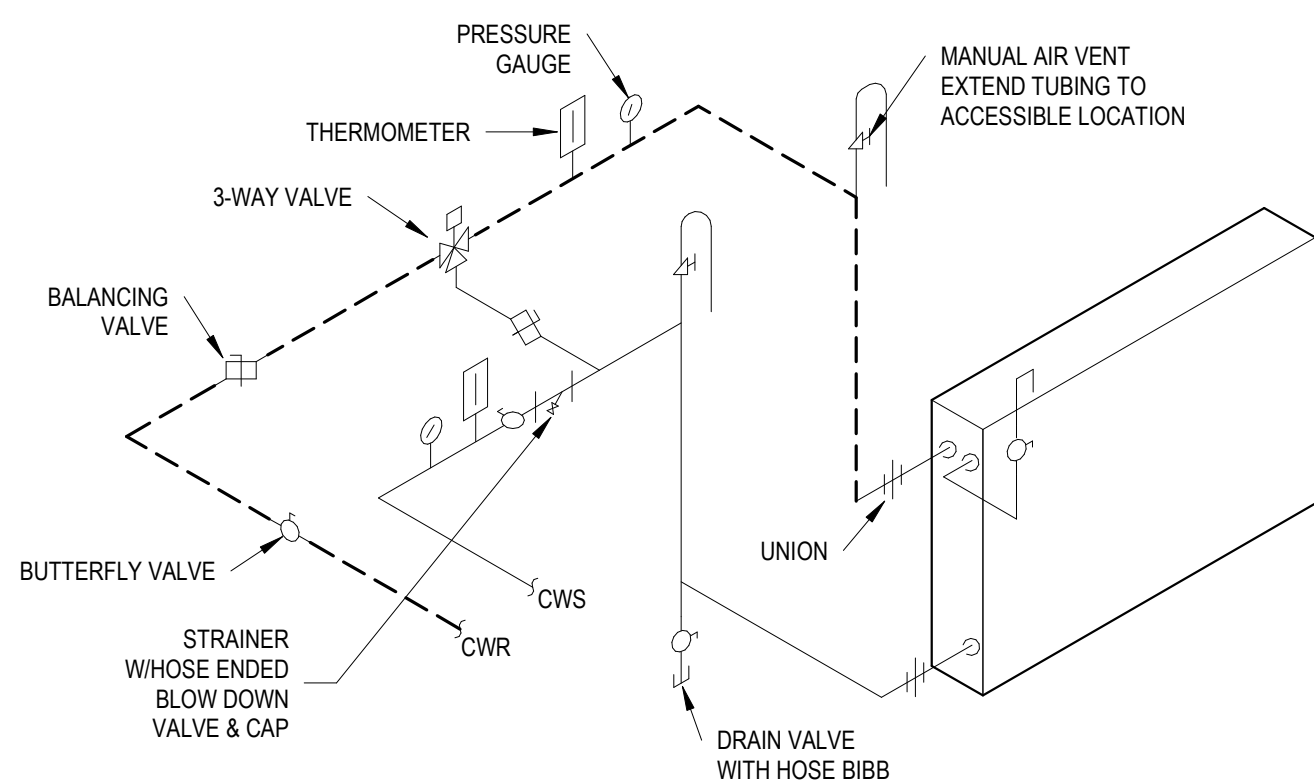

5
M-402
CHILLED WATER COOLING COIL DETAIL
NO SCALE MECHANICAL

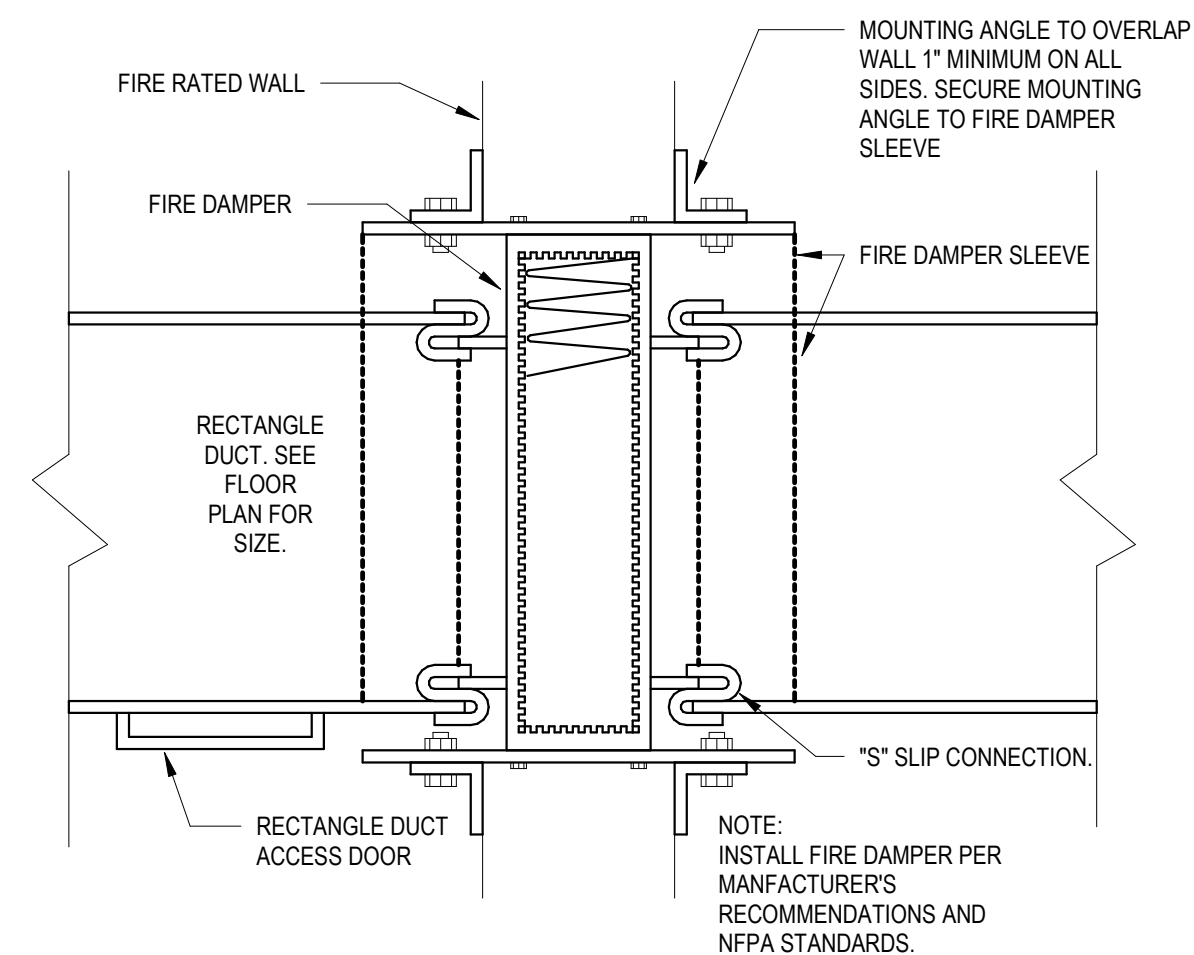


6
M-402
FIRE DAMPER
NO SCALE MECHANICAL

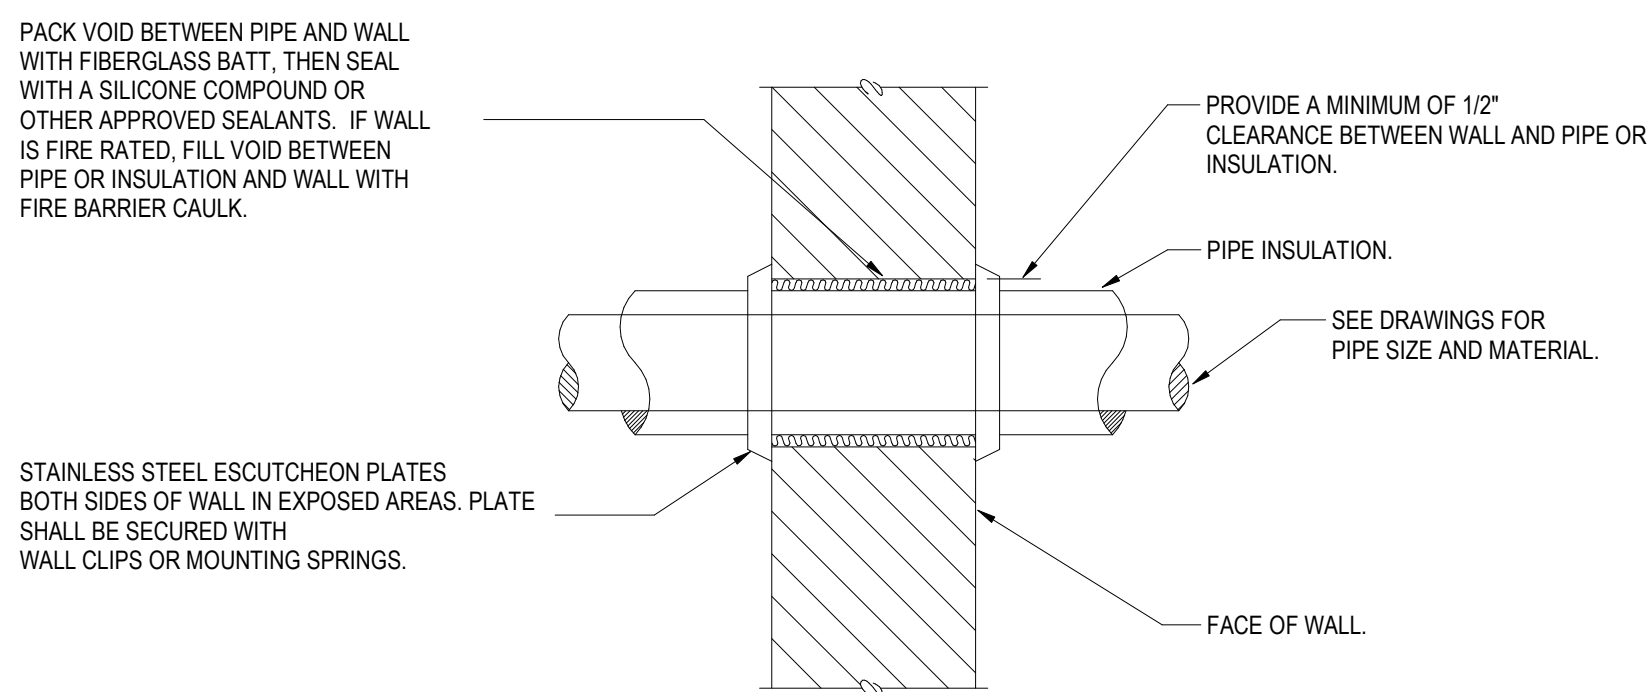

NOTES:
1. I.D. OF WALL OPENING TO BE A MIN. OF 1/2" LARGER THAN O.D. OF PIPE OR INSULATION PASSING THROUGH WALL.
2. CONTRACTOR SHALL BE RESPONSIBLE FOR THE COORDINATION OF THEIR WALL OPENINGS WITH OTHER TRADES AND/OR CONTRACTORS.
3. PIPE PENETRATIONS OF SMOKE OR FIRE WALLS SHALL BE IN COMPLIANCE WITH NFPA-90A.


9
M-402
PIPE PENETRATION OF INTERIOR WALL DETAIL
NO SCALE MECHANICAL

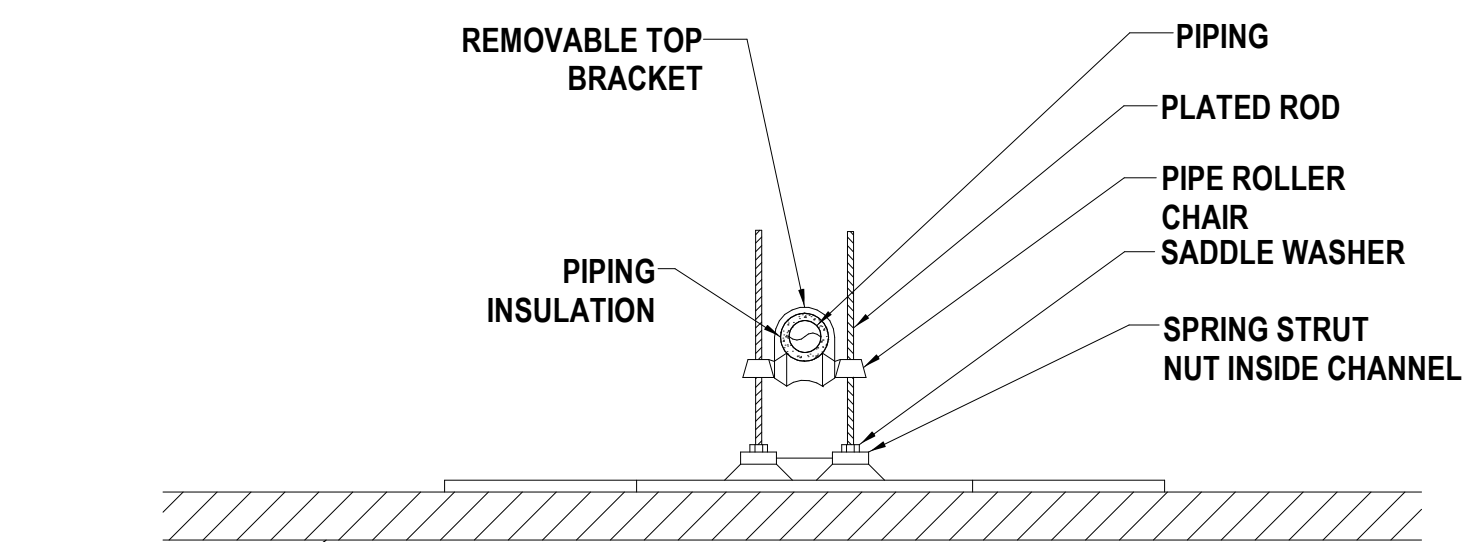

NOTES:
1. PIPING ON ROOF SHALL BE SUPPORTED 8'-0" ON CENTER AND AT ALL TURNS. CURB SHALL BE TAPERED TYPE AND MATCH THE PITCH OF THE ROOF.
2. SEE ARCHITECTURAL DRAWING FOR ROOF CURB INSTALLATION DIRECTIONS AND ROOFING.

10
M-402
PIPING SUPPORT ON ROOF
NO SCALE MECHANICAL

NO.	DESCRIPTION	DATE
	ISSUED FOR BID	06/28/21
Δ	ADDENDUM #3	07.27.21

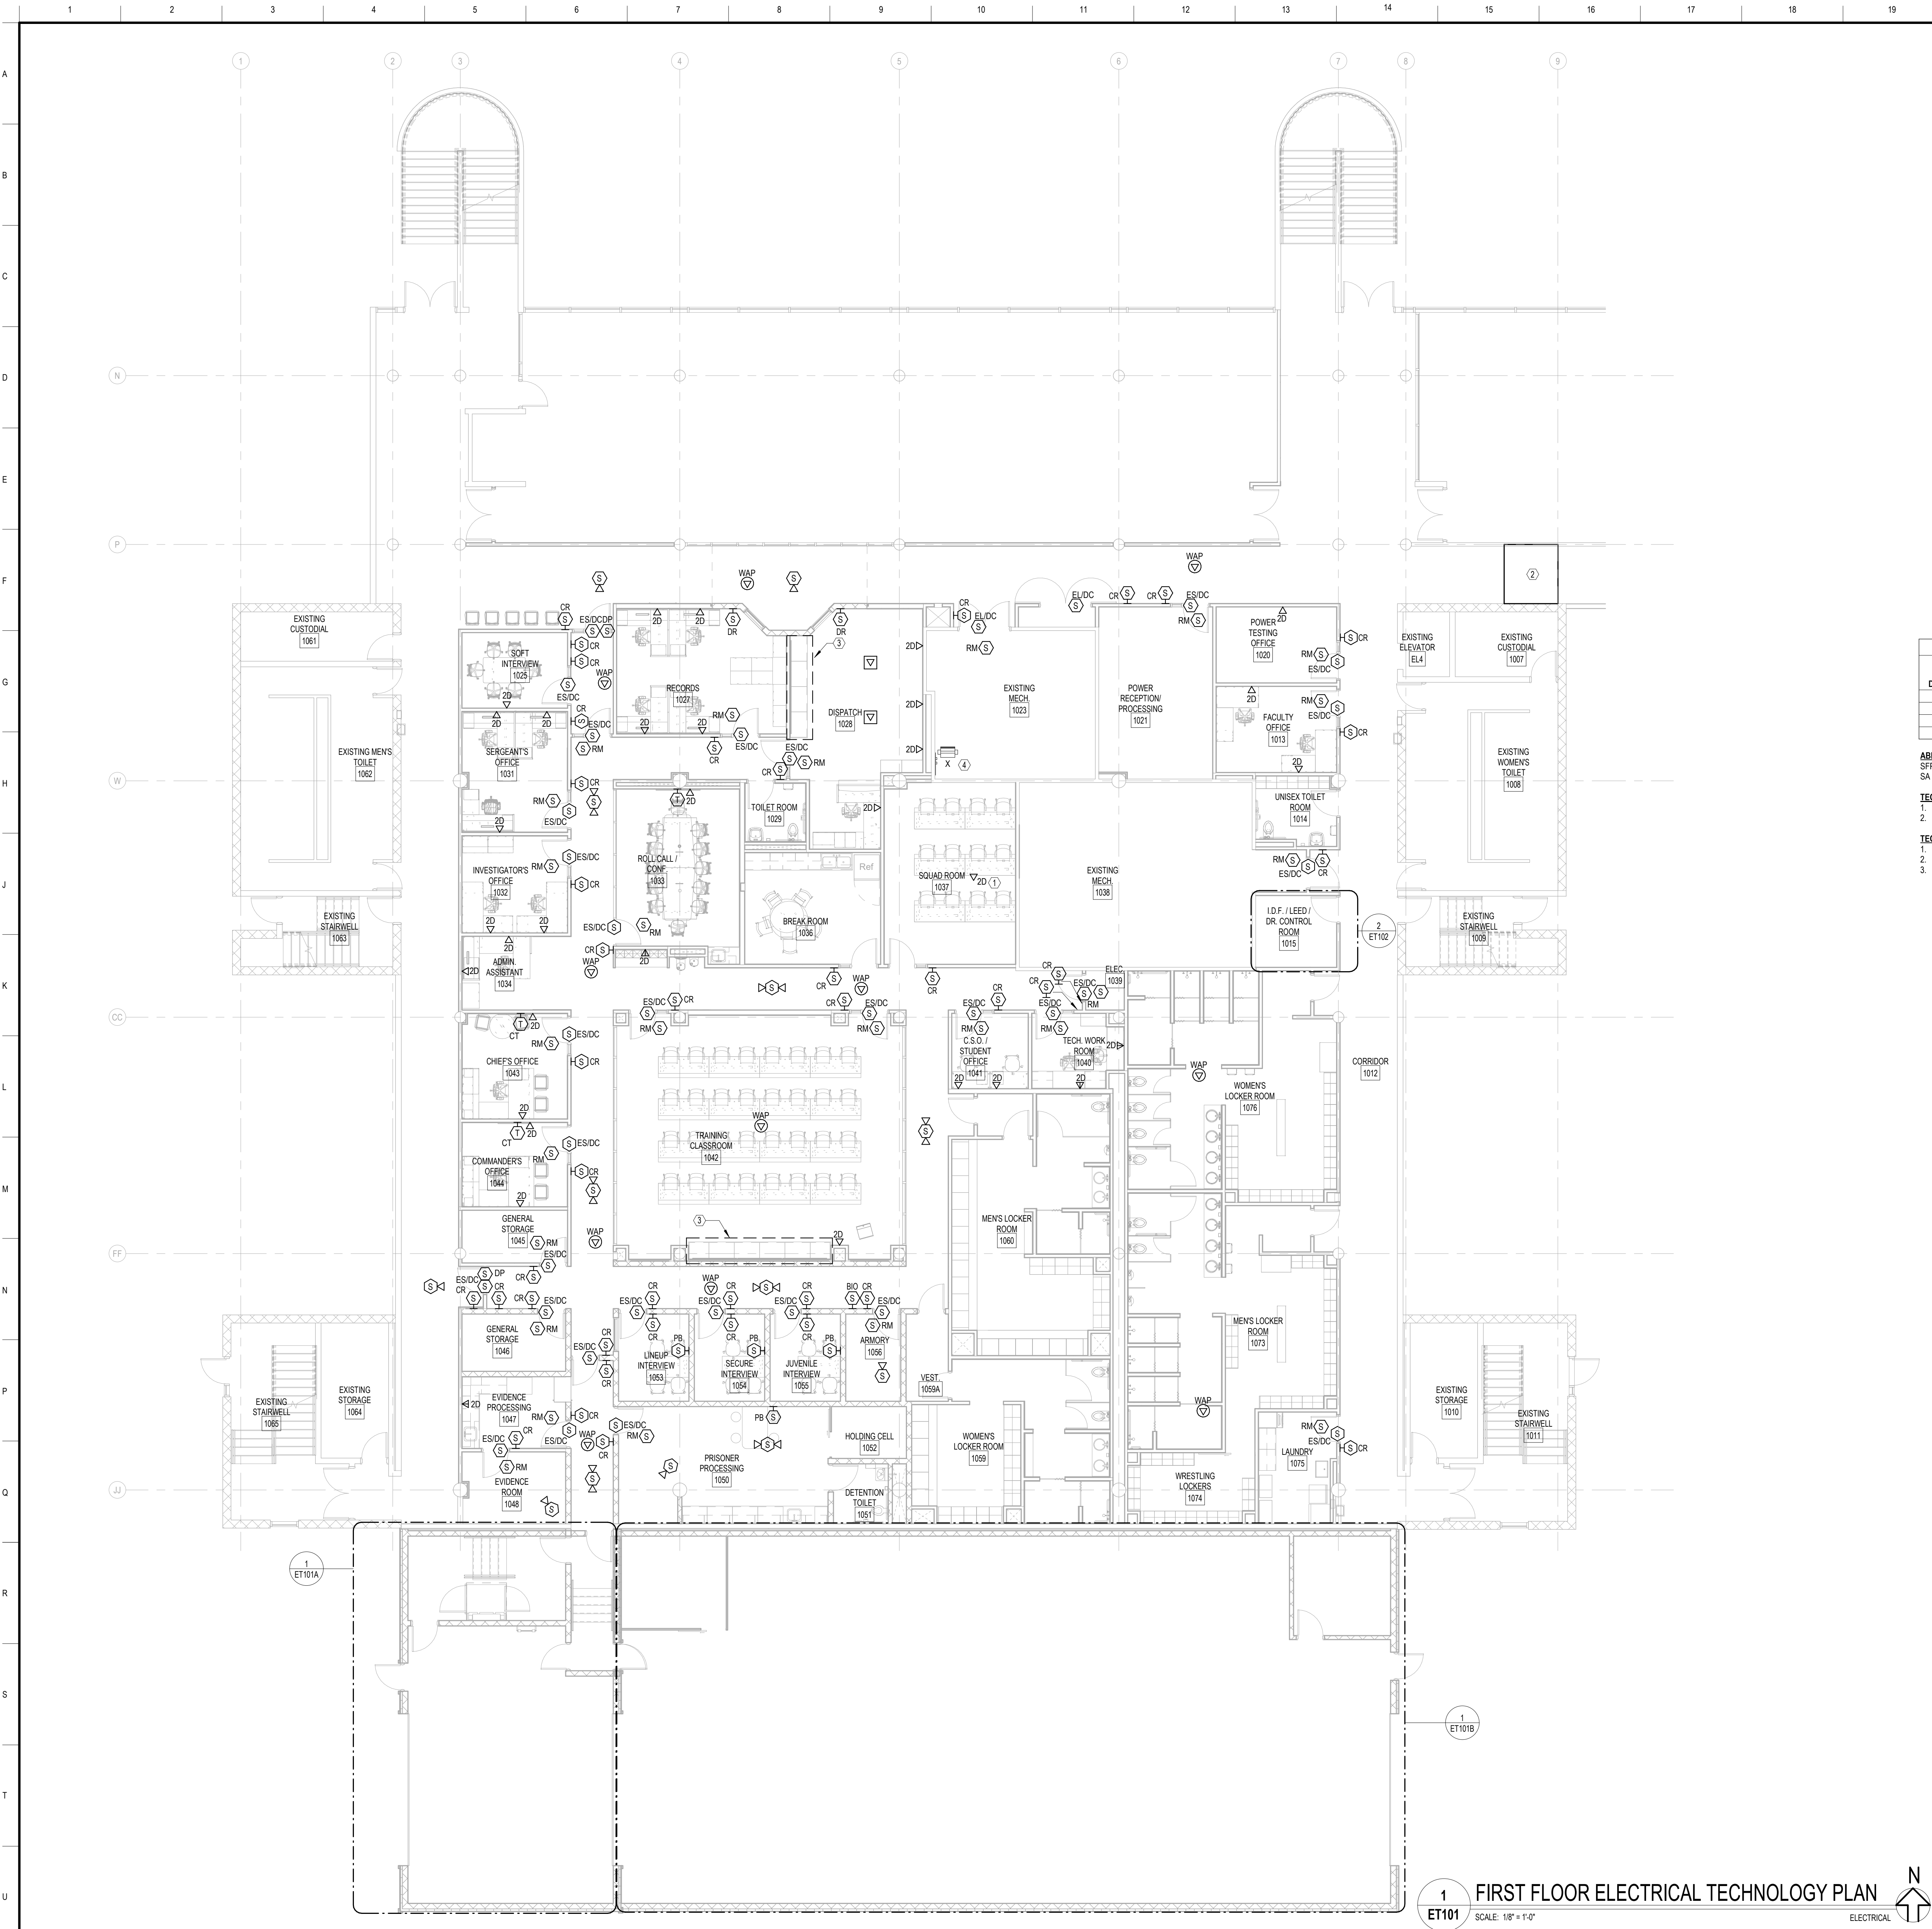

- GENERAL NOTES:**
- REFER TO SYMBOLS ON SHEET ET000 AND PROJECT SPECIFICATIONS FOR CONSTRUCTION STANDARDS.
 - ALL CEILING MOUNTED DEVICES SHALL BE CENTERED AND BETWEEN ARCHITECTURAL ELEMENTS IN DRYWALL SOFFITS/CEILING. ALL CEILING MOUNTED DEVICES SHALL BE INSTALLED AT MID OR QUARTER POINTS OF ACOUSTICAL CEILING PANELS UNLESS NOTED OTHERWISE.
 - COORDINATE ALL DEVICE LOCATIONS WITH ARCHITECTURAL ELEVATIONS.
 - COORDINATE GROMMETS THROUGH COUNTERTOP TABLES IF EQUIPMENT OUTLET IS LOCATED BELOW COUNTERTOP TABLETOP.
 - ELECTRICAL CONTRACTOR TO PROVIDE CABLING FOR CAMERAS, ACCESS CONTROL, WAPS, AND DATA LOCATIONS. ALL CABLING SHALL BE ROUTED TO IDF/LEEDOR CONTROL ROOM 1015 UNLESS NOTED OTHERWISE. REFER TO SCHEDULE ON THIS SHEET FOR CABLING REQUIREMENTS.
 - ALL CABLING TO BE COLOR CODED PER OWNER STANDARDS.
 - OWNER TO PROVIDE AND INSTALL ALL WAPS, PHONES, SECURITY CAMERAS, CARD READERS AND NETWORK SWITCHES. OWNER TO PROVIDE ELECTRIC STRIKES AND PANIC HARDWARE. CONTRACTOR TO MAKE FINAL TERMINATIONS. COORDINATE ALL FINAL DEVICE LOCATIONS WITH THE OWNER PRIOR TO ROUGH-IN.
 - REFER TO DETAIL 2ET000 FOR DOOR SECURITY ROUGH-IN REQUIREMENTS.
 - TECHNOLOGY CONTRACTOR TO PROVIDE ALL TVS AND FULL MOTION WALL MOUNTS.
A. DISPATCH TO HAVE (6) 55" MONITORS. SAMSUNG 55" CLASS TU7000 MOUNT. LEGRAND CHIEF TSS25T SERIES (OR APPROVED EQUAL).
B. TRAINING ROOM TO HAVE (6) 75" MONITORS. SAMSUNG 75" CLASS TU7000 MOUNT. LEGRAND CHIEF TSS25T SERIES (OR APPROVED EQUAL).
C. ALL OTHER TVS TO BE 55" SAMSUNG 55" CLASS TU7000 MOUNT. LEGRAND CHIEF TSS25T SERIES (OR APPROVED EQUAL).

- KEYNOTES:**
- PROVIDE A CEILING MOUNTED DATA RECEPTACLE FOR THE OWNER PROVIDED PROJECTOR. COORDINATE FINAL LOCATION WITH THE OWNER PRIOR TO ROUGH-IN.
 - APPROXIMATE LOCATION OF SECOND FLOOR ELECTRICAL CLOSET CONTAINING THE TELEVISION ANTENNA.
 - REFER TO DETAIL 4ET102 FOR INSTALLATION REQUIREMENTS.
 - EXISTING PHONE BLOCKS AND DATA RACK TO REMAIN.

CONSTRUCTION AND DEMOLITION TO BE DONE IN PHASES SO THAT EXISTING DISPATCH CENTER REMAINS OPERATIONAL UNTIL SWITCHOVER TO FULLY FUNCTIONAL NEW DISPATCH CENTER CAN BE COMPLETED. IF NECESSARY, PROVIDE TEMPORARY POWER TO EXISTING DISPATCH AREA TO ENSURE DISPATCH IS OPERATIONAL DURING ANY SHUTDOWNS. ALL SHUTDOWNS WILL NEED STRICT APPROVAL BY CAMPUS POLICE.

SCOPE NOTE:
CONTRACTOR TO WORK WITH THE OWNER'S CURRENT DISPATCH SYSTEM VENDOR (DIGITAL SKY) TO RELOCATE THE EXISTING EQUIPMENT. THE DISPATCH AREA WILL BE OPERATING DURING CONSTRUCTION. COORDINATE ALL NECESSARY DOWNTIMES WITH THE CAMPUS POLICE.

TECHNOLOGY OUTLET SCHEDULE							
DEVICE TYPE	DESCRIPTION	OUTLET TYPE	MOUNTING HEIGHT	DATA CABLES			REMARKS
				DATA CABLE TYPE	CABLE COUNT	TERMINATION	
ZD	DATA	WALL MOUNTED	18" AFF	CAT 6	2	PATCH PANEL	
CCTV	SECURITY CAMERA	CEILING MOUNTED	--	CAT 6	1	PATCH PANEL	1
CT	CABLE TV	WALL MOUNTED	--	RG-6	1	--	3
WAP	WIRELESS ACCESS POINT	CEILING MOUNTED	--	CAT 6	2	PATCH PANEL	2

- ABBREVIATIONS:**
SFP = SEE FLOOR PLAN
SA = SEE ARCHITECTURAL DETAILS
- TECHNOLOGY OUTLET GENERAL REMARKS:**
- REFER TO DETAIL 4ET000 FOR CABLE LABELING REQUIREMENTS.
 - COORDINATE CABLE LABELING SCHEME WITH OWNER PRIOR TO INSTALLATION.
- TECHNOLOGY OUTLET SCHEDULE REMARKS:**
- PROVIDE 20' SERVICE COIL AT SECURITY CAMERAS ABOVE CEILING.
 - PROVIDE 20' SERVICE COIL AT WIRELESS ACCESS POINT LOCATION ABOVE CEILING.
 - MOUNTED ADJACENT TO TELEVISION. VERIFY FINAL TV MOUNTING HEIGHT WITH OWNER PRIOR TO INSTALLATION.

LEGAT ARCHITECTS
DESIGN | PERFORMANCE | SUSTAINABILITY

**JOLIET
JUNIOR
COLLEGE**

**CAMPUS POLICE
RENOVATIONS**

1215 Houbolt Road
Joliet, IL 60431

ARCHITECT
Legat Architects

2015 Spring Road, Suite 175
Oak Brook, IL, 60523
P: 630.990.3541
www.legat.com

CIVIL ENGINEER
RT&A Inc.

129 Capista Drive
Shorewood, IL 60404
P: 815.744.5600
www.ruettigertonnelli.com

STRUCTURAL ENGINEER
Pease Borst & Associates

18 Executive Court
South Barrington, IL 60010
P: 847.842.6930
F: 847.842.6935
www.peaseborst.com

ME/P/EP ENGINEER
RTM Engineering Consultants

650 E. Algonquin, Suite 250
Schaumburg, IL 60173
P: 847.756.4180
www.rtmec.com

rtm
engineering consultants
650 E. Algonquin Road | Suite 250 | Schaumburg, IL 60173
P: 847.756.4180 | F: 847.756.4188 | www.rtmec.com



SIGNATURE
DATE: 5/25/2021

REVISIONS		
NO.	DESCRIPTION	DATE
	ISSUED FOR BID	06/28/21
Δ	ADDENDUM #3	07.27.21

PROJECT NUMBER 220122.00
DATE OF ISSUE 06.28.21
DRAWN BY CML
CHECKED BY JLI

**FIRST FLOOR
ELECTRICAL
TECHNOLOGY PLAN**

ET101
ISSUED FOR BID

1 FIRST FLOOR ELECTRICAL TECHNOLOGY PLAN
ET101 SCALE: 1/8" = 1'-0" ELECTRICAL